

MISSISSIPPI DEPARTMENT OF NATURAL RESOURCES

Bureau of Land and Water Resources

COUNTY WELL LOCATED
MARSHAL

WELL NUMBER **J 2118** CODEB

DATE WELL COMPLETED
5-7-90

PERMIT NUMBER
HICKS WELL CO.

NAME OF DRILLING FIRM
RT. 1 BOX 157

SENATOBIA, MS 38668

P.O. Box 10631
Jackson, Mississippi 39209
WATER WELL DRILLERS LOG

NAME & MAILING ADDRESS OF LANDOWNER
P. O. HOLLY SPRINGS
AITER WEST

WELL LOCATION: SEC **32** TOWNSHIP **3 N** RANGE **4 W**

DISTANCE **5** Miles **W** of **HOLLY SP**

OTHER LANDMARK

WELL PURPOSE Irrigation, Municipal, Industrial, Fish Pond, etc.

PUMP DATA

PUMP TYPE (Circle One):
 Submersible Turbine, Jet, Flowing Well,
Other (Describe)

POWER TYPE (Circle One):
 Electric Tractor, Diesel, Gasoline, Butane,
Other (Describe) **H/P**

Pump Capacity (GPM) **10** No. of Stages **12** Setting Depth **160** FT.

PUMP TEST

Well yielded **18** GPM with
a drawdown of _____ ft.
after _____ hours of pumping

WELL DATA

Well Depth **200** Casing Diameter (In.) **4"** Casing Length (Ft.) **190**

Type of Casing **PVC** Hole Depth **200** Depth to Static Water Level **130**

TYPE OF COMPLETION: (Circle One or More):
 Travel Packer Underreamed, Telescoped,
Natural Development, Open Hole, Other
(Describe)

Top of Lap Pipe or Reduction in Casing

FEET IF TELESCOPED OR MORE THAN ONE SCREEN: USE BACK PAGE

LOG DATA

TYPE OF LOG RUN (Circle One): No Log Run,
Electric, Gamma Ray, Density, Sonic, Neutron,
Other (Describe)

Name of Organization Running Log

SCREEN DATA

Diameter - Inches **4"** Length - Feet **10'** Slot Size - Inches **013**

Screen Type **PVC** Depth to Bottom - Feet **10'**

GEOLOGIC DATA (Office Use Only)

Surface Elev.	Geologic Unit	Unit Thickness	Depth to Top
Subs. SWL	Date	Analysis	Aquifer Test


Driller's Remarks

DESCRIPTION OF FORMATIONS ENCOUNTERED	FROM	TO	FORMATIONS (Continued)	FROM	TO
RC + S	0	30	RECEIVED JUN 07 1990 Department of Natural Resources Bureau of Land & Water Resources		
RS.	30	90			
WS	90	200			

IF MORE SPACE IS NEEDED, USE BACK

If well telescopes please
sketch and show depths.

GROUND LEVEL

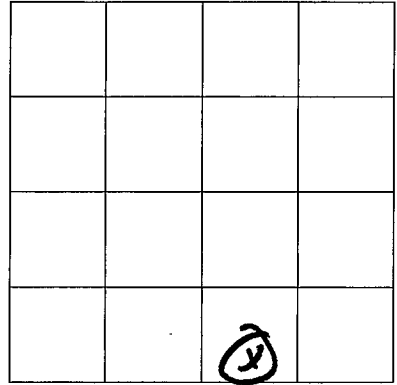

SECTION _____

Please indicate well location X.

ADDITIONAL INFORMATION

If more than one screen,
show location of each on sketch.