

MISSISSIPPI DEPARTMENT OF ENVIRONMENTAL QUALITY
Bureau of Land and Water Resources

P. O. Box 10631
Jackson, MS 39289-0631
WATER WELL DRILLERS LOG

COUNTY WELL LOCATED MARSHAL	
WELL NUMBER 2-2126	CODED
DATE WELL COMPLETED 3-5-91	

PERMIT NUMBER
NAME OF DRILLING PARTY HICKS WELL CO.
RT. 1 BOX 157
SENATOBIA, MS 38668

NAME & MAILING ADDRESS OF LANDOWNER Awendolyn Moore		
RT 6 Box 598		
Byhalia, ms 38611		
WELL LOCATION: SEC	TOWNSHIP	RANGE
2	3	4
DISTANCE DIRECTION NEAREST TOWN 3 Miles S of Byhalia		
OTHER LANDMARK		
WELL PURPOSE (Home) Irrigation, Municipal, Industrial, Fish Pond, etc.		

PUMP DATA		
PUMP TYPE (Circle One): <input checked="" type="radio"/> Submersible Turbine Jet Flowing Well, Other (Describe) _____		
POWER TYPE (Circle One): <input checked="" type="radio"/> Electric Tractor Diesel Gasoline Butane, Other (Describe) _____ H/P 1/2		
Pump Capacity (GPM) 10	No. of Stages 9	Setting Depth 120 FT.
PUMP TEST		
Well yielded 10 GPM with a drawdown of _____ ft. after _____ hours of pumping		

WELL DATA		
Well Depth 140	Casing Diameter (In.) 4"	Casing Length (Ft.) 140
Type of Casing PVC	Hole Depth 140	Depth to Static Water Level 100
TYPE OF COMPLETION: (Circle One or More): <input checked="" type="radio"/> Gravel Packed Underreamed Telescoped, Natural Development, Open Hole, Other		
Top of Lap Pipe or Reduction in Casing FEET IF TELESCOPED OR MORE THAN ONE SCREEN: USE BACK PAGE		

LOG DATA	
TYPE OF LOG RUN (Circle One): <input type="radio"/> No Log Run, <input type="radio"/> Electric, <input type="radio"/> Gamma Ray, <input type="radio"/> Density, <input type="radio"/> Sonic, <input type="radio"/> Neutron, Other (Describe) _____	
Name of Organization Running Log	

SCREEN DATA		
Diameter - Inches 4"	Length - Feet 10'	Slot Size - Inches 013
Screen Type PVC	Depth to Bottom - Feet 10	


GEOLOGIC DATA (Office Use Only)			
Surface Elev.	Geologic Unit	Unit Thickness	Depth to Top
Subs. SWL	Date	Analysis	Aquifer Test
Driller's Remarks			

DESCRIPTION OF FORMATIONS ENCOUNTERED	FROM	TO	FORMATIONS (Continued)	FROM	TO
DIRT	0	10	RECEIVED APR 12 1991 Dept. of Environmental Quality Bureau of Land & Water Resources		
CLAY	10	80			
SAND	80	140			

IF MORE SPACE IS NEEDED, USE BACK

If well telescopes please sketch and show depths.

GROUND LEVEL

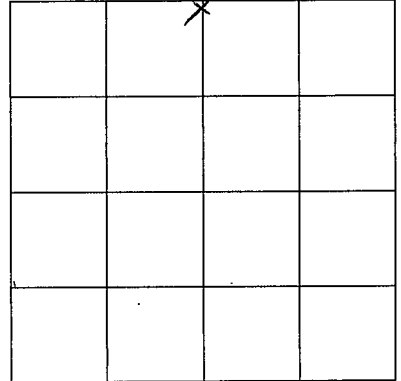

SECTION _____

Please indicate well location X.

ADDITIONAL INFORMATION

If more than one screen,
show location of each on sketch.