


If well telescopes please sketch and show depths.

GROUND LEVEL

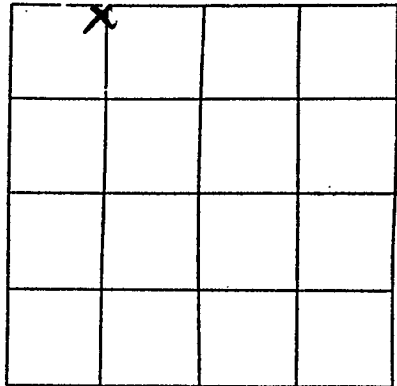

SECTION 17

Please indicate well location X.

Pump Capacity (GPM)	No. of Stages	Setting Depth
<u>10</u>	<u>11</u>	<u>135</u> FT.

PUMP TEST

Well yielded _____ GPM with
a drawdown of _____ ft.
after _____ hours of pumping

LOG DATA

TYPE OF LOG RUN (Circle One): _____ No Log Run.
Electric, Gamma Ray, Density, Sonic, Neutron,
Other (Describe) _____

Name of Organization Running Log

GEOLOGIC DATA (Office Use Only)

Surface Elev.	Geologic Unit	Unit Thickness	Depth to Top
Subs. SWL	Date	Analysis	Aquifer Test

Driller's Remarks

3/4 hp - plm
wm 6 bladder

If more than one screen,
show location of each on sketch.