


If well telescopes please sketch and show depths.

GROUND LEVEL

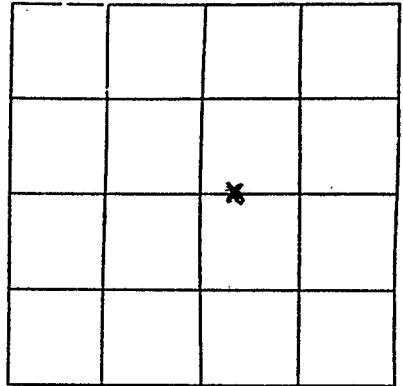

SECTION 205-15

Please indicate well location X.

| | | |
|----------------------------------|---------------------------|---------------------------------|
| Pump Capacity (GPM) <u>10</u> | No. of Stages <u>9</u> | Setting Depth <u>140</u> FT. |
|----------------------------------|---------------------------|---------------------------------|

PUMP TEST

Well yielded 10 GPM with
a drawdown of _____ ft.
after _____ hours of pumping

LOG DATA

TYPE OF LOG RUN (Circle One): No Log Run,
Electric, Gamma Ray, Density, Sonic, Neutron,
Other (Describe) _____

Name of Organization Running Log _____

GEOLOGIC DATA (Office Use Only)

| Surface Elev. | Geologic Unit | Unit Thickness | Depth to Top |
|---------------|---------------|----------------|--------------|
| Subs. SWL | Date | Analysis | Aquifer Test |

Driller's Remarks

If more than one screen,
show location of each on sketch.