

Marshall
 K3
 5-6-69

MISSISSIPPI
 BOARD OF WATER COMMISSIONERS
 416 North State Street
 Jackson, Mississippi 39201

CODED

WATER WELL DRILLERS LOG

may 6 1969 *Earl Jones Well Co* *Marshall*
 date well completed firm name county well located

LANDOWNER:
W.C. Hall
Red Bank miss.
 (mailing address)
 WELL LOCATION:
 sec 4 T 3 N R 3 E
 S W
3 1/2 miles N.E. of Red Bank
 (distance) (direction) (nearest town)

description of formations encountered	from	to
<i>Topsoil</i>	<i>0</i>	<i>8</i>
<i>sand</i>	<i>8</i>	<i>63</i>
<i>clay</i>	<i>63</i>	<i>66</i>
<i>sand</i>	<i>66</i>	<i>70</i>
<i>clay</i>	<i>70</i>	<i>78</i>
<i>sand</i>	<i>78</i>	<i>145</i>

WELL PURPOSE:
 (home, irrigation, municipal, industrial)

WELL COMPLETION DATA:
 (1) diameter (inches) 2
 (2) total depth (feet) 145
 (3) static water level (feet) 110 below above top of ground.
 (4) casing plastic 139 ft
 (material) (depth)
2" If telescope see back.
 (size)
 (5) screen 6 ft 139 ft
 (length) (depth to top)
2" plastic-gravel
 (size) (material)
 (6) pump 1 3 1/2
 (HP) (yield gpm)
Electric
 (type power)
 (7) electric log no
 (yes or no)
 (organization running log)
 (8) how well bottom plugged brushshot

CODED


MAY 26 1969

MISS. BD. OF
 WATER COM. L.

DRILLERS REMARKS:

If well telescopes please sketch and show depths.

GROUND LEVEL

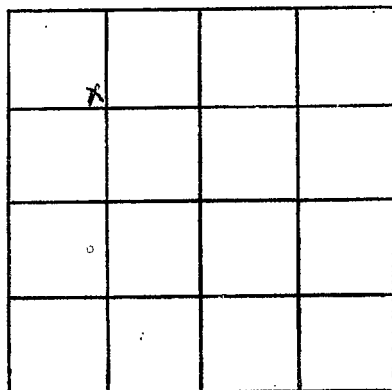

SECTION 4

Please indicate well location X.

ADDITIONAL INFORMATION

If more than one screen, show locations of each on sketch.