

Marshall
K 6
12-2-69

MISSISSIPPI
 BOARD OF WATER COMMISSIONERS
 416 North State Street
 Jackson, Mississippi 39201

CODED

WATER WELL DRILLERS LOG

12-2- 1969 Thorpe Well Supply Co. Marshall
 date well completed firm name county well located

LANDOWNER: Quentin H. Whitlock
Route 4
Holly Springs, Miss.
 (mailing address)

description of formations encountered	from	to
Top Soil	0	10
Red SAND	10	25
White clay & Sand mix	25	75
Brown Coarse SAND	75	105
White Coarse SAND	105	120
White med SAND	120	140
White Coarse SAND	140	162

WELL LOCATION: 156
 sec. 17 T. 3 R. 3
2 miles E of Red Banks
 (distance) (direction) (nearest town)

WELL PURPOSE:
 (home) irrigation, municipal, industrial

WELL COMPLETION DATA:

(1) diameter (inches) 4"

(2) total depth (feet) 162'

(3) static water level (feet) 105 ^(below) _(above) top of ground.

(4) casing PVC (NSF), 158,
 (material) (depth)
 (size) if telescope see back.

(5) screen 4', 158
 (length) (depth to top)
4", PVC Filter Pack
 (size) (material)

(6) pump 1/3, 8
 (HP) (yield gpm)
220 SP
 (type power)

(7) electric log NO
 (yes or no)

(organization running log)

APR - 8 1970


MISS. BD. OF
 WATER COMMS

(8) how well bottom plugged End
of screen 4" cap

DRILLERS REMARKS:

If well telescopes please sketch and show depths.

GROUND LEVEL

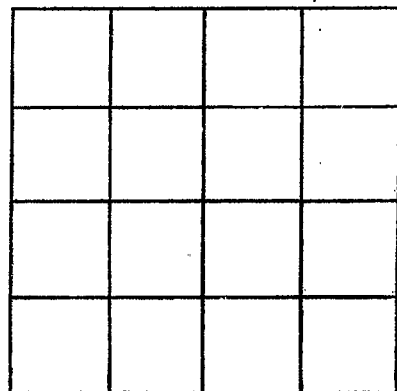

SECTION _____

Please indicate well location X.

ADDITIONAL INFORMATION

If more than one screen, show locations of each on sketch.