

Marshall
K7
12-3-70

MISSISSIPPI
 BOARD OF WATER COMMISSIONERS
 416 North State Street
 Jackson, Mississippi 39201

CODED

WATER WELL DRILLERS LOG

12-3- date well completed 1969 Theepe Well Supply Co. firm name Marshall county well located

LANDOWNER: Oscar C. & Ethel Brown
Route # 4
Holly Springs, Miss.
 (mailing address)

description of formations encountered	from	to
Top Soil	0	10
Brown Fine Sand	10	35
" Coarse Sand	35	95
White med sand	95	120
White coarse sand	120	146

WELL LOCATION: 156
 sec. 17 T-3 R-3 W-W
2 miles E of Red Banks
 (distance) (direction) (nearest town)

WELL PURPOSE:
 (home; irrigation, municipal, industrial)

WELL COMPLETION DATA:

(1) diameter (inches) 4"

(2) total depth (feet) 146'

(3) static water level (feet) 95 below above top of ground.

(4) casing PVC (1.5" E) 142'
 (material) (depth)
 (size) if telescope see back.

(5) screen 4' 142'
 (length) (depth to top)
4" PVC Filter Pack
 (size) (material)

(6) pump 1/3 8
 (HP) (yield gpm)
220 SP.
 (type power)

(7) electric log NO
 (yes or no)

(organization running log)

(8) how well bottom plugged End of screen 7" cap


APR - 8 1970

MISS. BD. OF
 5571

DRILLERS REMARKS:

If well telescopes please sketch and show depths.

GROUND LEVEL

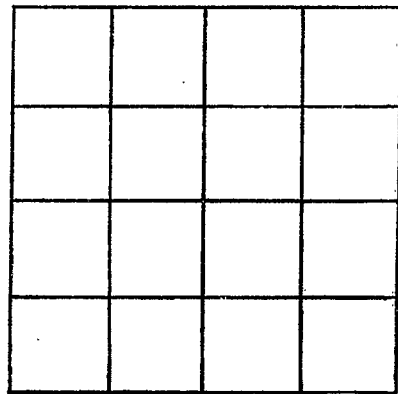

SECTION _____

Please indicate well location X.

ADDITIONAL INFORMATION

If more than one screen,
show locations of each on sketch.