

Marshall
 K 10
 6-19-70

MISSISSIPPI
 BOARD OF WATER COMMISSIONERS
 416 North State Street
 Jackson, Mississippi 39201

CODED

WATER WELL DRILLERS LOG

6-19-1970 date well completed
 J. Allison & Frost firm name
 Marshall county well located

LANDOWNER:
 I V Hawkins
 Holly Springs Miss
 (mailing address)

description of formations encountered	from	to
Red Clay	0	5
Red Sand	5	40
White Sack	40	100

WELL LOCATION:
 sec. 1 T 3 N R 3 E
 5 miles S of Red Banks
 (distance) (direction) (nearest town)

WELL PURPOSE:
 (home, irrigation, municipal, industrial)

WELL COMPLETION DATA:

- (1) diameter (inches) 4 1/2
- (2) total depth (feet) 100
- (3) static water level (feet) _____ below above top of ground.
- (4) casing PVC 90 (material) (depth)
 _____ if telescope see back.
 (size)
- (5) screen 10ft 90 (length) (depth to top)
 _____ (size) _____ (material)
- (6) pump 1/2 10 (HP) (yield gpm)
 Elec (type power)
- (7) electric log _____ (yes or no)
 _____ (organization running log)
- (8) how well bottom plugged _____

CODED


JUL 10 1970

DRILLERS REMARKS:

MISS. BD. OF
 WATER COMMISSIONERS

If well telescopes please sketch and show depths.

GROUND LEVEL

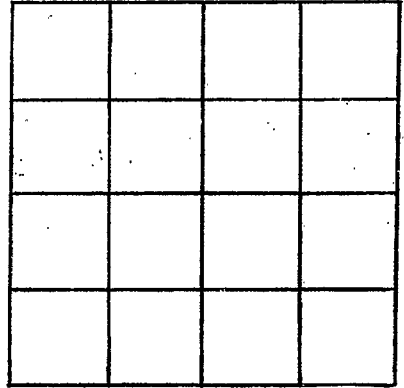

SECTION _____

Please indicate well location X.

ADDITIONAL INFORMATION

If more than one screen, show locations of each on sketch.