

MARSHALL

K11

7-2-70

MISSISSIPPI
 BOARD OF WATER COMMISSIONERS
 416 North State Street
 Jackson, Mississippi 39201

CODED

WATER WELL DRILLERS LOG

July 2 1970 Bumpas Well Co. Marshall
 date well completed firm name county well located

LANDOWNER:

Tom Allen
 Rt. 4 Box 248 Holly Springs
 (mailing address) N.C.

description of formations encountered

from

to

Clay

0 20

Sand

20 60

Clay

60 85

Sand

85 130

WELL LOCATION:

30 T 3 N R 3 E
 sec. (S) (W)
 7 miles NORTH of Holly Springs
 (distance) (direction) (nearest town)

WELL PURPOSE: Drilling (home, irrigation, municipal, industrial)

WELL COMPLETION DATA:

(1) diameter (inches) 4"

(2) total depth (feet) 130 feet

(3) static water level (feet) 90 below top of ground.

(4) casing PVC 130 feet (material) (depth)

(size) If telescope see back.

(5) screen 6 ft. 12 6 ft. (length) (depth to top)

1/2" gravel wall (size) (material)

(6) pump 3/4 HP 10 (type power) (yield gpm)

(type power)

(7) electric log Elect. (yes or no)

(organization running log)

(8) how well bottom plugged 4" cap.


CODED

AUG 12 1970

DRILLERS REMARKS:

If well telescopes please sketch and show depths.

GROUND LEVEL

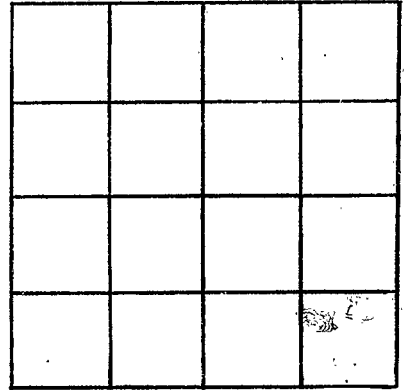

SECTION _____

Please indicate well location X.

ADDITIONAL INFORMATION

If more than one screen, show locations of each on sketch.