

MARSHALL
K12
12-8-70

MISSISSIPPI
 BOARD OF WATER COMMISSIONERS
 416 North State Street
 Jackson, Mississippi 39201

CODED

WATER WELL DRILLERS LOG

Dec 8 19 70 Lumpas Well Co. Marshall
 date well completed firm name county well located
Alvin Kent

LANDOWNER:
Paul E. Stewart
Holly Springs, Miss.
 (mailing address)
 WELL LOCATION:
 sec. 28 T 3 N R 3 E
3 miles west of HIS.
 (distance) (direction) (nearest town)

description of formations encountered	from	to
	clay	0
sand	20	160
clay	160	180
sand	180	220

WELL PURPOSE: Dwelling
 (home, irrigation, municipal, industrial)

- WELL COMPLETION DATA:
- (1) diameter (inches) 4"
 - (2) total depth (feet) 220 feet
 - (3) static water level (feet) 180 below above top of ground.
 - (4) casing PVC 220 feet
 (material) (depth)
 (size) If telescope see back.
 - (5) screen 1/2" 214 feet
 (length) (depth to top)
4" gravel wall
 (size) (material)
 - (6) pump 3/4 10
 (HP) (yield gpm)
 (type power)
 - (7) electric log elect.
 (yes or no)
 (organization running log)
 - (8) how well bottom plugged 4" cap.

CODED


JAN 7 - 1971

MISS. RD. OF
 WATER COMM.

DRILLERS REMARKS:

If well telescopes please sketch and show depths.

GROUND LEVEL

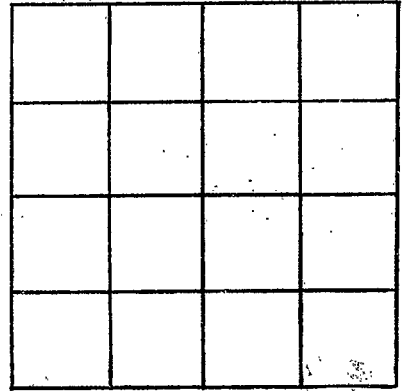

SECTION _____

Please indicate well location X.

ADDITIONAL INFORMATION

If more than one screen, show locations of each on sketch.