

MISSISSIPPI  
BOARD OF WATER COMMISSIONERS,  
416 North State Street  
Jackson, Mississippi 39201

**CODED**

WATER WELL DRILLERS LOG

MARSHALL  
K13  
2-27-71

Feb-27 1971 date well completed  
Fisher Drilling Co. firm name  
Marshall county well located

LANDOWNER: Albert Taylor  
Rt. 2 Box 488  
Colliersville, Tenn.  
(mailing address)

description of formations encountered	from	to
Clay	0	18
Gravel	18	23
Sand	23	90
Clay	90	102
Sand	102	135
Clay	135	140
Sand	140	188

WELL LOCATION:  
sec. 29 T 3 N R 3 W  
5 miles west of Holly Springs  
(distance) (direction) (nearest town)

WELL PURPOSE: Home  
(home, irrigation, municipal, industrial)

WELL COMPLETION DATA:

(1) diameter (inches) 4"

(2) total depth (feet) 188 ft.

(3) static water level (feet) 140 (below top of ground)

(4) casing plastic, 178 (depth)  
(material) (size) if telescope see back.

(5) screen 10 ft, 178 ft (length) (depth to top)  
4" plastic (size) (material)

(6) pump 3/4 HP, 12 (yield gpm)  
(type power) 220 V.A.C.

(7) electric log No. (yes or no)

(organization running log)

(8) how well bottom plugged plastic cap

**CODED**


MAR 24 1971

DRILLERS REMARKS:

MISS. BD. OF  
WATER COMM.

If well telescopes please sketch and show depths.

GROUND LEVEL

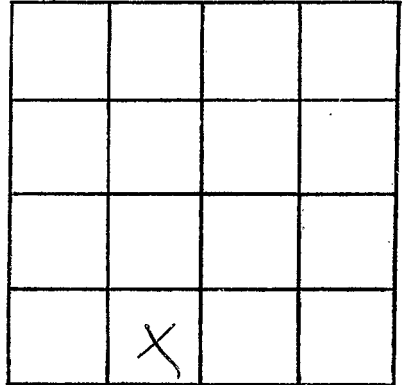

SECTION 29

Please indicate well location X.

ADDITIONAL INFORMATION

Lined area for additional information.

If more than one screen, show locations of each on sketch.