

MARSHALL

K 16

6-18-62

WATER WELL DRILLERS LOG

CODED

Date: 6-18, 1962, Driller: Adam Bros. Co. Inc County Marshall

(Name)

(1) Owner of Land: W.A. Matthews
(Name)

Holly Springs, Rte 4
(Address)

(2) Location: 1/4, 1/4, Sec 18 33
T R

 miles of
(distance) (direction) (Nearest Town)

(3) Topography:
(Hilly) (Flat) (Level)

(4) Purpose of Well:
(Domestic Irrigation
Municipal, Industrial, Other)

Information upon completion of well:

(1) Diameter 4 inches.

(2) Total Depth 184 feet.

(3) Water Level 120 feet below top of ground.

(4) Cased to 177, Size .

(5) Screen: Size 4", Length 7'.

(6) Were any formations sealed against pollution?
 yes, no.


If YES depth of formation .

Why .

Drillers Remarks:

Description & Color of Materials Sand, Clay, Red Clay, Shell, etc.	Thick- ness Feet	Depth Feet
<u>top soil</u>	<u>0-15</u>	
<u>red sand</u>	<u>15-40</u>	
<u>clay</u>	<u>40-50</u>	
<u>sand</u>	<u>50-140</u>	
<u>fine sand</u>	<u>140-160</u>	
<u>coarse sand</u>	<u>160-185</u>	

CODED

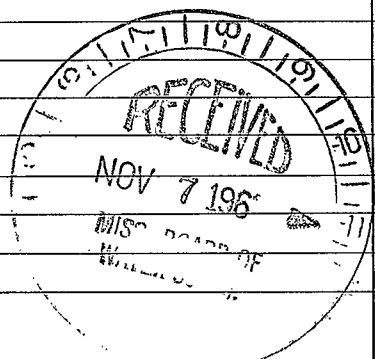

(Use Back Side)

Well No.

