

MARSHALL
 # K20
 8-67

MISSISSIPPI
 BOARD OF WATER COMMISSIONERS
 416 North State Street
 Jackson, Mississippi 39201

CODED

WATER WELL DRILLERS LOG

8-5 1967 Leake Well Co Marshall
 date well completed firm name county well located

LANDOWNER:

James M. Cain

description of formations encountered

from to

Red Banks mass
 (mailing address)

<u>Surface clay</u>	<u>1</u>	<u>15</u>
<u>Clay + sand</u>	<u>15</u>	<u>75</u>
<u>White clay</u>	<u>75</u>	<u>125</u>
<u>Loose sand</u>	<u>125</u>	<u>155</u>
<u>Coarse sand</u>	<u>155</u>	<u>170</u>

WELL LOCATION:

sec. 32 T. 8 N. R. 3 E.
4 1/2 miles South of Red Banks
 (distance) (direction) (nearest town)

WELL PURPOSE:

Home
 (home, irrigation, municipal, industrial)

WELL COMPLETION DATA:


- (1) diameter (inches) 4"
- (2) total depth (feet) 170
- (3) static water level (feet) 130 below above top of ground.
- (4) casing Plastic, 164,
 (material) (depth)
 if telescope see back.
 (size)
- (5) screen 6', 164
 (length) (depth to top)
4", Plastic
 (size) (material)
- (6) pump 1/2, 10
 (HP) (yield gpm)
Elec
 (type power)
- (7) electric log No
 (yes or no)

 (organization running log)
- (8) how well bottom plugged Plastic

CODED


DRILLERS REMARKS:

Good Water Supply

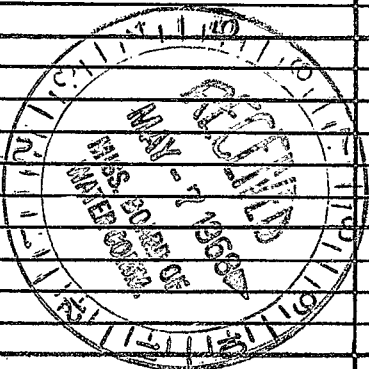

If well telescopes please sketch and show depths.

GROUND LEVEL

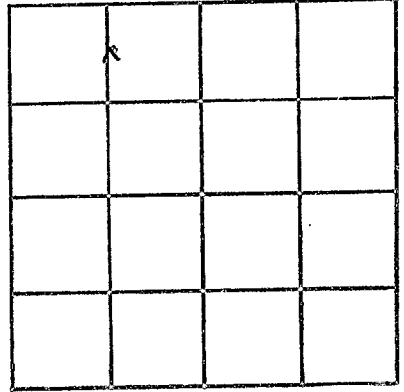

SECTION _____

Please indicate well location X.

ADDITIONAL INFORMATION

If more than one screen,
show locations of each on sketch.