

Marshall
 K 21
 4-67

MISSISSIPPI
 BOARD OF WATER COMMISSIONERS
 416 North State Street
 Jackson, Mississippi 39201

CODED

WATER WELL DRILLERS LOG

April 29 1967 R. L. Carpenter Marshall
 date well completed firm name county well located

LANDOWNER: New Hope Church
Red Banks,
Miss. R.F.D.
 (mailing address)

WELL LOCATION:
 sec. 4 T. 3 N R. 3 E
 S W
3 miles northeast of Red Banks
 (distance) (direction) (nearest town)

WELL PURPOSE: Church
 (home, irrigation, municipal, industrial)


WELL COMPLETION DATA:

- (1) diameter (inches) 4 in.
- (2) total depth (feet) 134
- (3) static water level (feet) 90 below above top of ground.
- (4) casing Plastic, 128,
 (material) (depth)
 _____ if telescope see back.
 (size)
- (5) screen 6 ft., 128
 (length) (depth to top)
4 in., Plastic Gravel
 (size) (material)
- (6) pump 1/2, 10
 (HP) (yield gpm)
Eleco
 (type power)
- (7) electric log No
 (yes or no)

 (organization running log)
- (8) how well bottom plugged Plastic Plug

description of formations encountered	from	to
<u>surface soil</u>	<u>0</u>	<u>18</u>
<u>Med. Red Sand</u>	<u>18</u>	<u>60</u>
<u>Med. white sand</u>	<u>60</u>	<u>78</u>
<u>Coarse white sand</u>	<u>78</u>	<u>105</u>
<u>White Clay</u>	<u>105</u>	<u>110</u>
<u>white coarse sand</u>	<u>110</u>	<u>134</u>

CODED

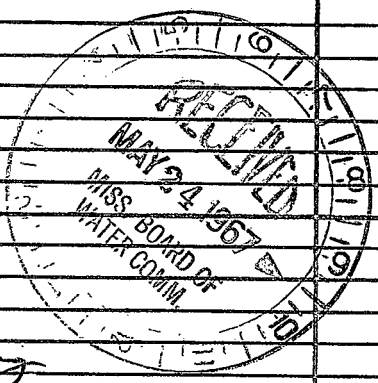


DRILLERS REMARKS:

If well telescopes please sketch and show depths.

GROUND LEVEL

R 3W

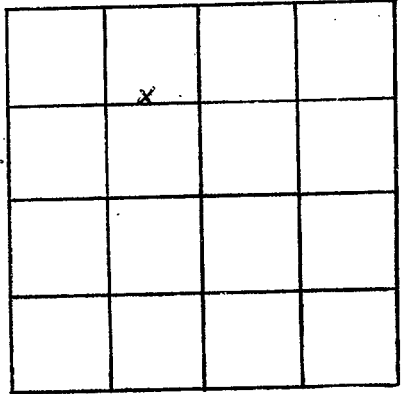

SECTION 4

Please indicate well location X.

ADDITIONAL INFORMATION

If more than one screen, show locations of each on sketch.