

Marshall
K22
8-26-68
8-26
date well completed

Atherton & Frost

MISSISSIPPI
BOARD OF WATER COMMISSIONERS
416 North State Street
Jackson, Mississippi 39201

CODED

WATER WELL DRILLERS LOG

1968 J.W. Sands from Marshall
firm name county well located

LANDOWNER:

M. O. V. Whitten

(mailing address)

description of formations encountered

from

to

red clay	0	15
red sand	15	25
white clay	25	85
blue clay	85	100
rock	100	101
blue clay	101	137
rock	137	139
white sand	139	152

WELL LOCATION:

sec. 1 T. 3 N. R. 3 E.
5 miles (311) of (311) of (W) of (nearest town)


WELL PURPOSE:

(home, irrigation, municipal, industrial)

WELL COMPLETION DATA:

- (1) diameter (inches) 4"
- (2) total depth (feet) 152
- (3) static water level (feet) 110 below top of ground
- (4) casing (material) (depth) (size) if telescope see back.
- (5) screen 10ft 142 (length) (depth to top) (size) (material)
- (6) pump 3 (HP) 10 (yield gpm) 230 (type power)
- (7) electric log 710 (yes or no) (organization running log)
- (8) how well bottom plugged


CODED

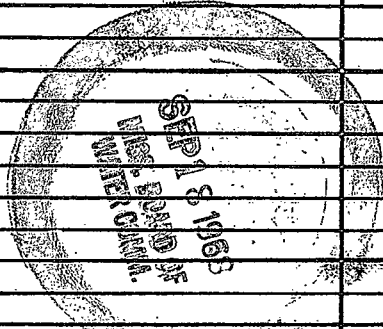

DRILLERS REMARKS:

If well telescopes please sketch and show depths.

GROUND LEVEL

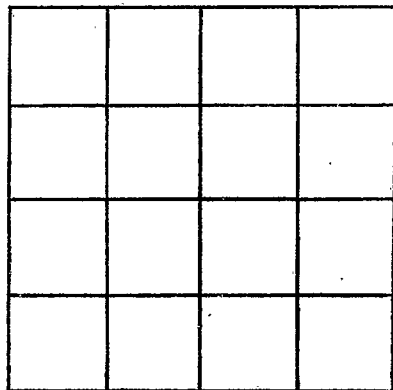

SECTION 1

Please indicate well location X.

ADDITIONAL INFORMATION

If more than one screen, show locations of each on sketch.