

Marshall  
 K23  
 9-67

MISSISSIPPI  
 BOARD OF WATER COMMISSIONERS  
 416 North State Street  
 Jackson, Mississippi 39201

**CODED**

WATER WELL DRILLERS LOG

Sept 14, 1967 R. L. Carpenter Marshall  
 date well completed firm name county well located

LANDOWNER: Wall Doney Jr.  
Holly Springs, Miss.  
 (mailing address)

description of formations encountered	from	to
Surface Soil	0	11
Red Clay	11	20
Coarse white sand	20	122
White Clay	122	124
White Coarse sand	124	220

WELL LOCATION:  
 sec 28 T 3 N R 3 E  
 S W  
3 1/2 miles West of Holly Springs  
 (distance) (direction) (nearest town)

WELL PURPOSE: Farm  
 (home, irrigation, municipal, industrial)

WELL COMPLETION DATA:

- (1) diameter (inches) 4 in.
- (2) total depth (feet) 220
- (3) static water level (feet) 180 below top of ground.
- (4) casing Plastic 2 1/4  
 (material) (depth)
- \_\_\_\_\_ if telescope see back.  
 (size)
- (5) screen 6 ft., 2 1/4  
 (length) (depth to top)
- 4 in., Plastic Gravel  
 (size) (material)
- (6) pump 3/4 10  
 (HP) (yield gpm)
- Elec.  
 (type power)
- (7) electric log No.  
 (yes or no)
- \_\_\_\_\_ (organization running log)
- (8) how well bottom plugged Plastic Plug

**CODED**




DRILLERS REMARKS:

If well telescopes please sketch and show depths.

GROUND LEVEL

R 3 W

T35

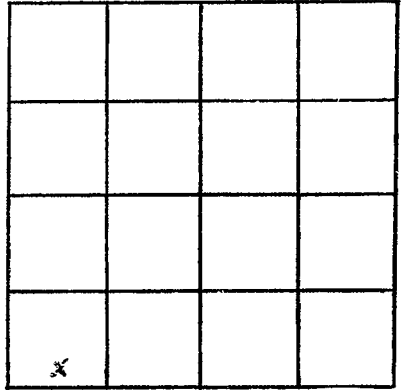

SECTION 28

Please indicate well location X.

ADDITIONAL INFORMATION

If more than one screen, show locations of each on sketch.