

MARSHALL

K 25

1-26-72

MISSISSIPPI  
 BOARD OF WATER COMMISSIONERS  
 416 North State Street  
 Jackson, Mississippi 39201

**CODED**

WATER WELL DRILLERS LOG

1/26/

1972

G. and H. Well Company

Marshall

date well completed

firm name

county well located

| LANDOWNER:  | description of formations encountered | from | to  |
|---|---------------------------------------|------|-----|
| <del>Grand</del> Holly Hills Trailer Park                     |                                       |      |     |
| Hicks Furniture and Appl.                                     | Red Sand                              | 1    | 15  |
| College Avenue  | White Clay                            | 15   | 25  |
| Holly Springs, Mississippi                                    | White Clay                            | 25   | 35  |
| WELL LOCATION:  | White Clay                            | 35   | 45  |
| sec. <u>33</u> T <u>33</u> N                                  | White Clay                            | 45   | 55  |
| <u>1</u> miles SE of <u>Holly Springs</u>                     | White Clay                            | 55   | 65  |
| (distance) (direction) (nearest town)                         | White Sand & Clay                     | 65   | 75  |
| WELL PURPOSE: Home  | White Sand & Clay                     | 75   | 85  |
| (home, irrigation, municipal, industrial)                     | White Sand                            | 85   | 95  |
| WELL COMPLETION DATA:   | " "                                   | 95   | 105 |
| (1) diameter (inches) <u>4 inch</u>                           | " "                                   | 105  | 115 |
| (2) total depth (feet) <u>255</u>                             | " "                                   | 115  | 125 |
| (3) static water level (feet) <u>165</u> below top of ground. | " "                                   | 125  | 135 |
| (4) casing <u>Plastic</u> , <u>255</u>                        | " "                                   | 135  | 145 |
| (material) (depth)  | " "                                   | 145  | 155 |
| (size) If telescope see back.                                 | " "                                   | 155  | 165 |
| (5) screen <u>5 ft.</u> , <u>255</u>                          | " "                                   | 165  | 175 |
| (length) (depth to top)                                       | " "                                   | 175  | 185 |
| <u>4 in</u> , <u>&amp; slotted</u>                            | " "                                   | 185  | 195 |
| (size) (material)   | " "                                   | 195  | 205 |
| (6) pump <u>3/4</u> <u>10 GPM</u>                             | " "                                   | 205  | 215 |
| (HP) (yield gpm)  | " "                                   | 215  | 225 |
| <u>Electric</u> <u>220</u>                                    | " "                                   | 225  | 235 |
| (type power)  | " "                                   | 235  | 245 |
| (7) electric log <u>No</u>                                    | " "                                   | 245  | 255 |
| (yes or no)   |                                       |      |     |
| (organization running log)                                    |                                       |      |     |
| (8) how well bottom plugged <u>Cap</u>                        |                                       |      |     |
| DRILLERS REMARKS:   |                                       |      |     |


**CODED**

JAN 21 1972

MISS. BD. OF  
WATER COM.

If well telescopes please sketch and show depths.

GROUND LEVEL

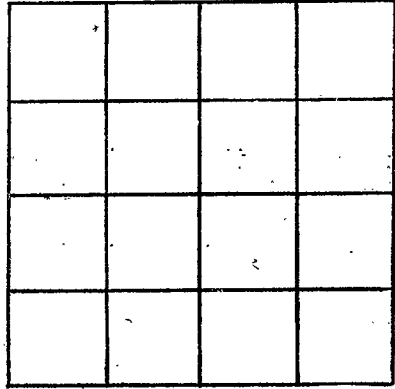

SECTION \_\_\_\_\_

Please indicate well location X.

ADDITIONAL INFORMATION

If more than one screen,  
show locations of each on sketch.