

**MARSHALL**  
**K 26**  
**2-22-72**

MISSISSIPPI  
 BOARD OF WATER COMMISSIONERS  
 416 North State Street  
 Jackson, Mississippi 39201

**CODED**

**MAR 9 1972**

**WATER WELL DRILLERS LOG**

Feb. 22 1972 Dean Kent Burges Marshall  
 date well completed firm name county well located

LANDOWNER:  
James H. Cavlett  
Holly Springs, Miss.  
 (mailing address)

description of formations encountered	from	to
<u>clay</u>	<u>0</u>	<u>20</u>
<u>Sand</u>	<u>20</u>	<u>80</u>
<u>clay</u>	<u>80</u>	<u>100</u>
<u>Sand</u>	<u>100</u>	<u>250</u>

WELL LOCATION:  
 sec 32 T 3 N R 3 E  
4 miles west of Holly Springs  
 (distance) (direction) (nearest town)

WELL PURPOSE: Drill well  
 (home, irrigation, municipal, industrial)


- WELL COMPLETION DATA:
- diameter (inches) 4"
  - total depth (feet) 220 feet
  - static water level (feet) 64 <sup>below</sup> 64 <sup>above</sup> top of ground.
  - casing PVC 220 feet  
 (material) (depth)  
 (size) if telescope see back.
  - screen 6 ft 21 feet  
 (length) (depth to top)  
4" ground well  
 (size) (material)
  - pump 3/4 12  
 (HP) (yield gpm)  
 (type power)
  - electric log elect  
 (yes or no)  
 (organization running log)
  - how well bottom plugged 4" cap

**CODED**

DRILLERS REMARKS:  
60 feet water  
300 well

If well telescopes please sketch and show depths.

GROUND LEVEL

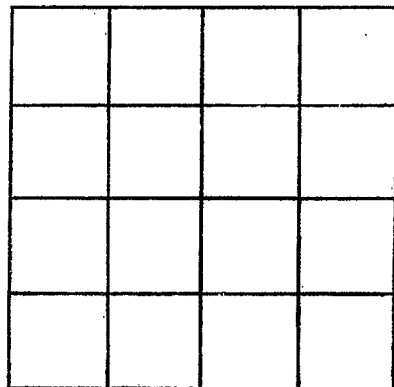

SECTION \_\_\_\_\_

Please indicate well location X.

ADDITIONAL INFORMATION

If more than one screen,  
show locations of each on sketch.