

MARSHALL
R 27
3-29-72

MISSISSIPPI
 BOARD OF WATER COMMISSIONERS
 416 North State Street
 Jackson, Mississippi 39201

CODED

WATER WELL DRILLERS LOG

3-29-72 1972 Dean Hart Burgess, Inc. Marshall
 date well completed firm name county well located

LANDOWNER:
 Robert Dean
 Holly Springs, Miss.
 (mailing address)

description of formations encountered	from	to
Clay	0	30
Sand	30	170

WELL LOCATION:
 sec. 14 T 3 N R 3 E
 5 miles N.W. of Holly Springs
 (distance) (direction) (nearest town)

WELL PURPOSE: Swimming
 (home, irrigation, municipal, industrial)

- WELL COMPLETION DATA:
- (1) diameter (inches) 4"
 - (2) total depth (feet) 170 feet
 - (3) static water level (feet) 95 1/2 below top of ground.
 - (4) casing PVC, 170 feet
 (material) (depth)
 (size) If telescope see back.
 - (5) screen 6 ft, 16 1/2 feet
 (length) (depth to top)
4" gravel wall
 (size) (material)
 - (6) pump 3/4, 14
 (HP) (yield gpm)
 (type power)
 - (7) electric log Elect
 (yes or no)
 (organization running log)
 - (8) how well bottom plugged 4" cog


CODED

APR 7 1972

DRILLERS REMARKS:

If well telescopes please sketch and show depths.

GROUND LEVEL

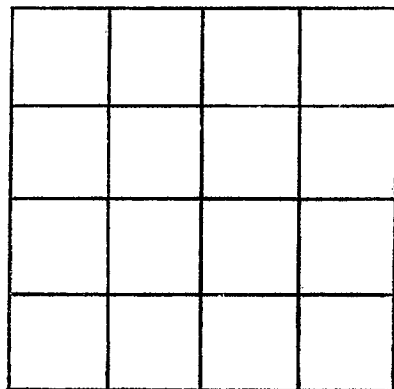

SECTION _____

Please indicate well location X.

ADDITIONAL INFORMATION

If more than one screen,
show locations of each on sketch.