

MARSHALL
K 28
4-72

MISSISSIPPI
 BOARD OF WATER COMMISSIONERS
 416 North State Street
 Jackson, Mississippi 39201

WATER WELL DRILLERS LOG

CODED

Atkinson & Frost Marshall

19 date well completed

firm name

county well located

LANDOWNER: *Miss Forestry*

description of formations encountered

from

to

Common. No. 10 Spring
Miss

<i>Red Clay</i>	<i>0</i>	<i>12</i>
<i>Red Sand</i>	<i>12</i>	<i>160</i>
<i>White Sand</i>	<i>160</i>	<i>240</i>
<i>White Clay</i>	<i>240</i>	<i>280</i>
<i>White Sand</i>	<i>280</i>	<i>320</i>

(mailing address)

WELL LOCATION:

sec. 1 T 3 N R. 3 E

2 1/2 miles N of *Bellevue*
 (distance) (direction) (nearest town)

WELL PURPOSE: *Home*
 (home, irrigation, municipal, industrial)

WELL COMPLETION DATA:

- (1) diameter (inches) 4
- (2) total depth (feet) 320
- (3) static water level (feet) 200 below top of ground.
- (4) casing P.V.C. (material) (depth)
- (size) if telescope see back.
- (5) screen 10 (length) 310 (depth to top)
- 4" (size) P.V.C. (material)
- (6) pump 3/4 (HP) 12 (yield gpm)
- Elec (type power)
- (7) electric log No (yes or no)

(organization running log)

(8) how well bottom plugged C.P.P.

DRILLERS REMARKS:


CODED

APR 19 1972

MISS. DEPT. OF
 WATER CONTROL

If well telescopes please sketch and show depths.

GROUND LEVEL

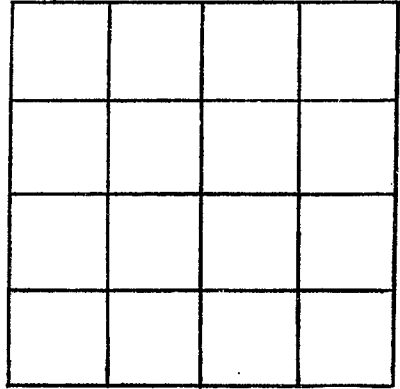

SECTION _____

Please indicate well location X.

ADDITIONAL INFORMATION

If more than one screen, show locations of each on sketch.