

**MARSHALL**  
**K 32**  
**6-30-72**

MISSISSIPPI  
 BOARD OF WATER COMMISSIONERS  
 416 North State Street  
 Jackson, Mississippi 39201

**CODED**

WATER WELL DRILLERS LOG

6-30 1972 Permit Kent Bunker well Marshall  
 date well completed firm name county well located

LANDOWNER:

F. B. Culler  
Neely Springs, Miss.  
 (mailing address)

description of formations encountered

Clay  
Sand

from

to

0 20

200 170

WELL LOCATION:

sec. 28 T 3 N R 3 E  
5 miles West of Neely Springs  
 (distance) (direction) (nearest town)

WELL PURPOSE:

Gardens  
 (home, irrigation, municipal, industrial)

WELL COMPLETION DATA:

- (1) diameter (inches) 4"
- (2) total depth (feet) 170 feet
- (3) static water level (feet) 120 below above top of ground.
- (4) casing 4" PVC, 170 feet  
 (material) (depth)  
 (size) if telescope see back.
- (5) screen 74", 163 feet  
 (length) (depth to top)  
4", gravel wall  
 (size) (material)
- (6) pump 3/4, 14  
 (HP) (yield gpm)  
 (type power)
- (7) electric log elect  
 (yes or no)  
 (organization running log)
- (8) how well bottom plugged 4" cop.

**CODED**


AUG 17 1972

MISS. 20. 03  
 WATER WELL

DRILLERS REMARKS:

If well telescopes please sketch and show depths.

GROUND LEVEL

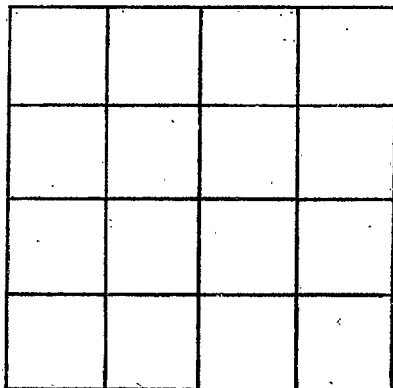

SECTION \_\_\_\_\_

Please indicate well location X.

ADDITIONAL INFORMATION

If more than one screen,  
show locations of each on sketch.