

MARSHALL
K 33
9-28-72

MISSISSIPPI
 BOARD OF WATER COMMISSIONERS
 416 North State Street
 Jackson, Mississippi 39201

WATER WELL DRILLERS LOG

CODED

Sept 28 1972 Earl Jones Well Co. Marshall
 date well completed firm name county well located

LANDOWNER:
Stanton Abernathy
Holly Springs, Miss
 (mailing address)

description of formations encountered	from	to
clay & topsoil	0	78
sand	78	110
clay	110	135
sand	135	160
streaks of clay & sand	160	185
sand	185	208

WELL LOCATION:
 sec 30 T 3 N R 3
3 1/2 miles SE. of Red Bank
 (distance) (direction) (nearest town)

WELL PURPOSE: Subsidence
 (home, irrigation, municipal, industrial)

- WELL COMPLETION DATA:
- (1) diameter (inches) 4"
 - (2) total depth (feet) 208
 - (3) static water level (feet) 130 below/above top of ground.
 - (4) casing plastic, 196
 (material) (depth)
4" if telescope see back.
 (size)
 - (5) screen 12', 196'
 (length) (depth to top)
4", plastic gravel
 (size) (material)
 - (6) pump 1 1/2, 20
 (HP) (yield gpm)
Electric
 (type power)
 - (7) electric log no
 (yes or no)
- (organization running log)
- (8) how well bottom plugged
plastic cap

CODED


OCT 10 1972

STATE OF MISSISSIPPI
 WATER COMMISSION

DRILLERS REMARKS:

If well telescopes please sketch and show depths.

GROUND LEVEL

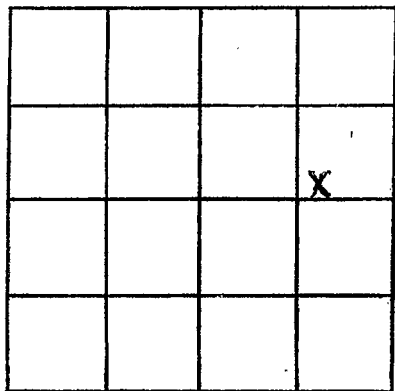

SECTION 30

Please indicate well location X.

ADDITIONAL INFORMATION

If more than one screen, show locations of each on sketch.