

**MARSHALL**  
**K 34**  
**11-3-72**

MISSISSIPPI  
 BOARD OF WATER COMMISSIONERS  
 416 North State Street  
 Jackson, Mississippi 39201

**WATER WELL DRILLERS LOG**

11-3-72 <sup>19</sup> Hicks Brothers Marshall  
 date well completed firm name county well located


LANDOWNER: <u>James R. Anderson</u>	description of formations encountered	from	to
<u>P.O. Holly Springs, Miss</u> (mailing address)	<u>Red clay</u>	<u>0</u>	<u>15</u>
	<u>Red sand</u>	<u>15</u>	<u>35</u>
	<u>White sand</u>	<u>35</u>	<u>125</u>
	<u>White sandy clay</u>	<u>125</u>	<u>215</u>
	<u>White sand</u>	<u>215</u>	<u>255</u>
WELL LOCATION: sec <u>34</u> T <u>3</u> N R <u>3</u> E (distance) (direction) (nearest town) <u>3</u> miles <u>E</u> of <u>Holly Springs</u>			
WELL PURPOSE: <u>Home</u> (home, irrigation, municipal, industrial)			
WELL COMPLETION DATA:			
(1) diameter (inches) <u>4"</u>			
(2) total depth (feet) <u>255</u>			
(3) static water level (feet) <u>178</u> below top of ground.			
(4) casing <u>Plastic</u> , <u>249</u> (material) (depth)			
_____ if telescope see back. (size)			
(5) screen <u>6'</u> , <u>248'</u> (length) (depth to top)			
<u>4"</u> , <u>Gravel</u> (size) (material)			
(6) pump <u>3/4</u> , <u>10</u> (HP) (yield gpm)			
<u>220 Elec</u> (type power)			
(7) electric log <u>No</u> (yes or no)			
_____ (organization running log)			
(8) how well bottom plugged <u>CAP</u>			
DRILLERS REMARKS:			

NOV 20 1972

MISS. LU  
 WATER COM

If well telescopes please sketch and show depths.

GROUND LEVEL.

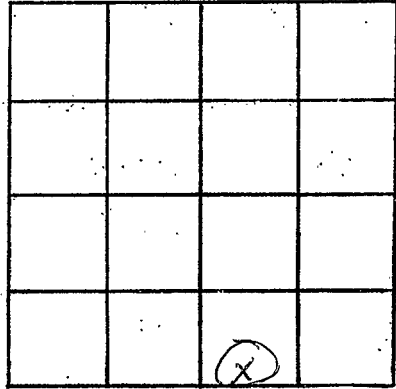

SECTION \_\_\_\_\_

Please indicate well location X.

ADDITIONAL INFORMATION

If more than one screen,  
show locations of each on sketch.