

MARSHALL
K 35
12-16-73

MISSISSIPPI
 BOARD OF WATER COMMISSIONERS
 416 North State Street
 Jackson, Mississippi 39201

CODED

WATER WELL DRILLERS LOG


12-16- 1973 Hicks Bro. Well Co. Marshall
 date well completed firm name county well located

LANDOWNER: <u>Syvester Payne</u>	description of formations encountered	from	to
<u>R. H.</u> <u>Holly Springs, Miss</u> (mailing address)	<u>Red clay</u>	<u>0</u>	<u>15</u>
	<u>Red sand</u>	<u>15</u>	<u>25</u>
	<u>White sand</u>	<u>25</u>	<u>157</u>
WELL LOCATION: sec. <u>3</u> T. <u>3</u> N. R. <u>3</u> E. <u>(S)</u> <u>(W)</u> <u>4 1/2</u> Miles miles <u>SE</u> of <u>Holly Springs</u> (distance) (direction) (nearest town)			
WELL PURPOSE: <u>Home</u> (home, irrigation, municipal, industrial)			
WELL COMPLETION DATA:			
(1) diameter (inches) <u>4"</u>			
(2) total depth (feet) <u>157</u>			
(3) static water level (feet) <u>97</u> below above top of ground.			
(4) casing <u>Plastic</u> , <u>1.51</u> (material) (depth)			
_____ if telescope see back. (size)			
(5) screen <u>6'</u> , <u>6'</u> (length) (depth to top)			
<u>4"</u> , <u>Gravel Plastic</u> (size) (material)			
(6) pump <u>3/4</u> <u>10</u> (HP) (yield gpm)			
<u>220 E100</u> (type power)			
(7) electric log <u>NO</u> (yes or no)			
_____ (organization running log)			
(8) how well bottom plugged <u>CAP</u>			
DRILLERS REMARKS:			

DEC 12 1973

If well telescopes please sketch and show depths.

GROUND LEVEL

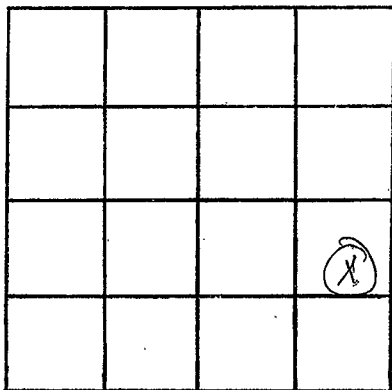

SECTION _____

Please indicate well location X.

ADDITIONAL INFORMATION

Lined area for additional information.

If more than one screen, show locations of each on sketch.