

**MARSHALL**  
**K 36**  
**2-2-73**

MISSISSIPPI  
 BOARD OF WATER COMMISSIONERS  
 416 North State Street  
 Jackson, Mississippi 39201

**CODED**

**WATER WELL DRILLERS LOG**

2-2 1973 Don Keith Bumpers MA Marshall  
 date well completed firm name county well located

LANDOWNER:	description of formations encountered	from	to
<u>Don Keith Bumpers</u>			
<u>Holly Springs, Miss.</u> (mailing address)	<u>Sand</u>	<u>20</u>	<u>200</u>

WELL LOCATION:  
 sec. 30 T. 3 N. R. 3 E.  
6 miles west of Holly Springs  
 (distance) (direction) (nearest town)

WELL PURPOSE: Swallow  
 (home, irrigation, municipal, industrial)

- WELL COMPLETION DATA:
- (1) diameter (inches) 4"
  - (2) total depth (feet) 200 feet
  - (3) static water level (feet) 132 below above top of ground.
  - (4) casing PVC, 200 feet  
 (material) (depth)  
 (size) If telescope see back.
  - (5) screen 7 ft, 193 feet  
 (length) (depth to top)  
4", gravel  
 (size) (material)
  - (6) pump 3/4, 14  
 (HP) (yield gpm)  
 (type power)
  - (7) electric log elect.  
 (yes or no)  
 (organization running log)
  - (8) how well bottom plugged 4" cap.

**COMPTON**


FEB 5 1973

DRILLERS REMARKS:

MISS. BD. OF  
 WATER COMMISSIONERS

If well telescopes please sketch and show depths.

GROUND LEVEL

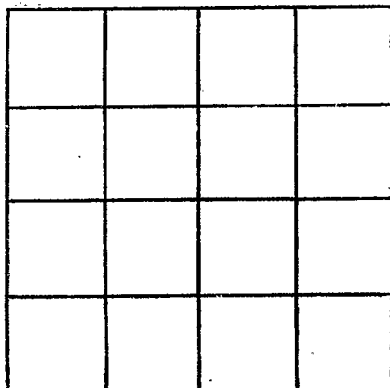

SECTION \_\_\_\_\_

Please indicate well location X.

ADDITIONAL INFORMATION

If more than one screen,  
show locations of each on sketch.