

MARSHALL
K 38
2-24-73

MISSISSIPPI
BOARD OF WATER COMMISSIONERS
416 North State Street
Jackson, Mississippi 39201

COPIED

WATER WELL DRILLERS LOG

Feb. 24 1973 Desert Kent Construction MARSHALL
date well completed firm name county well located

LANDOWNER:
J. W. Swain
Holly Springs, Miss.
(mailing address)

description of formations encountered	from	to
	<u>clay</u>	<u>0</u>
<u>Rock</u>	<u>20</u>	<u>30</u>

WELL LOCATION:
sec. 32 T 3 N R 3 E
5 miles West of Nashby Springs
(distance) (direction) (nearest town)

<u>clay</u>	<u>30</u>	<u>40</u>
<u>Sand</u>	<u>40</u>	<u>210</u>

WELL PURPOSE: Drinking
(home, irrigation, municipal, industrial)

WELL COMPLETION DATA:
(1) diameter (inches) 4"
(2) total depth (feet) 210 feet
(3) static water level (feet) 160 below above top of ground.
(4) casing PVC, 210 feet
(material) (depth)
(size) If telescope see back.
(5) screen 7 ft, 20.3
(length) (depth to top)
4" gravel wall
(size) (material)
(6) pump 3/4 14
(HP) (yield gpm)
(type power)
(7) electric log Elect.
(yes or no)
(organization running log)
(8) how well bottom plugged 4" cap.


COPIED

DRILLERS REMARKS:

MAR 2 1973

If well telescopes please sketch and show depths.

GROUND LEVEL

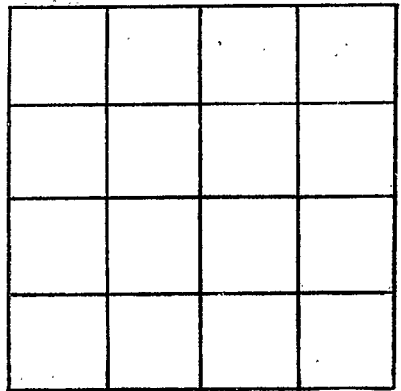

SECTION _____

Please indicate well location X.

ADDITIONAL INFORMATION

If more than one screen,
show locations of each on sketch.