

MARSHALL
K 39
3-2-72

MISSISSIPPI
 BOARD OF WATER COMMISSIONERS
 416 North State Street
 Jackson, Mississippi 39201

WATER WELL DRILLERS LOG

COPIED

3-2 1972 Dean Hart Bumpawells Marshall
 date well completed firm name county well located

LANDOWNER:
Richard Raines
OT 3. Box 190-1 Hales Springs
 (mailing address) 011551

description of formations encountered	from	to
	<u>clay</u>	<u>0</u>
<u>sand</u>	<u>30</u>	<u>190</u>

WELL LOCATION:
 sec. 32 T 3 N R 3 E
 (S) (W)
6 miles west of Hales Springs
 (distance) (direction) (nearest town)

WELL PURPOSE: Dwelling
 (home, irrigation, municipal, industrial)

- WELL COMPLETION DATA:**
- (1) diameter (inches) 4"
 - (2) total depth (feet) 190 feet
 - (3) static water level (feet) 140 ft below top of ground.
 - (4) casing pvc 190 feet
 (material) (depth)
 (size) if telescope see back.
 - (5) screen 2 1/2" 183 feet
 (length) (depth to top)
4" gravel
 (size) (material)
 - (6) pump 3/4 14
 (HP) (yield gpm)
 (type power)
 - (7) electric log elect.
 (yes or no)
 (organization running log)
 - (8) how well bottom plugged 4" cap


COPIED

APR 6 1972

DRILLERS REMARKS:

If well telescopes please sketch and show depths.

GROUND LEVEL

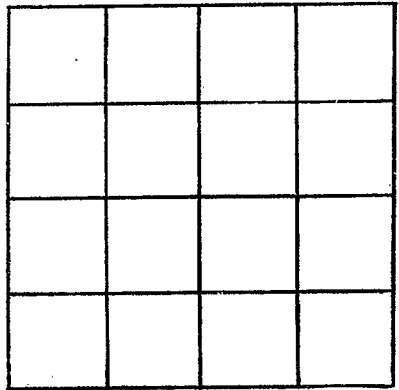

SECTION _____

Please indicate well location X.

ADDITIONAL INFORMATION

If more than one screen, show locations of each on sketch.