

MARSHALL
K40
3-73

MISSISSIPPI
 BOARD OF WATER COMMISSIONERS
 416 North State Street
 Jackson, Mississippi 39201

CODED

WATER WELL DRILLERS LOG

Atkinson & Fort Marshall

date well completed 19 firm name county well located

LANDOWNER:

Ray L. V. Kingston

Dolly Springs, Miss
 (mailing address)

WELL LOCATION:

sec. 1 T. 3 N. R. 3 E.
4 miles E of Holly Springs
 (distance) (direction) (nearest town)

WELL PURPOSE:

Home
 (home, irrigation, municipal, industrial)

WELL COMPLETION DATA:

- (1) diameter (inches) 4"
- (2) total depth (feet) 218
- (3) static water level (feet) 200 below above top of ground.
- (4) casing PVC
 (material) (depth)
 (size) If telescope see back.
- (5) screen 10 208
 (length) (depth to top)
4" PVC
 (size) (material)
- (6) pump 3/4 8
 (HP) (yield gpm)
Electric
 (type power)
- (7) electric log no
 (yes or no)

(organization running log)

(8) how well bottom plugged CAP.

description of formations encountered

from to

<i>Clay</i>	0	15
<i>red sand</i>	15	20
<i>Clay</i>	20	30
<i>Red sand</i>	30	80
<i>white clay</i>	80	180
<i>white sand</i>	180	198
<i>white clay</i>	198	198
<i>white sand</i>	198	218


CODED

DRILLERS REMARKS:

APR 18 1973

If well telescopes please sketch and show depths.

GROUND LEVEL

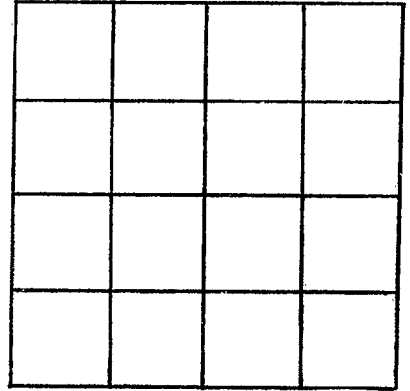

SECTION _____

Please indicate well location X.

ADDITIONAL INFORMATION

If more than one screen, show locations of each on sketch.