

MARSHALL

K41

3-73

MISSISSIPPI
 BOARD OF WATER COMMISSIONERS
 416 North State Street
 Jackson, Mississippi 39201

CODED

WATER WELL DRILLERS LOG

Atkinson & Kent Marshall

date well completed 19

firm name

county well located

LANDOWNER:

Jerry Panel
 Sally Spang Miss
 (mailing address)

description of formations encountered

from

to

Clay	0	10
Red Sand	10	30
white sand	30	50
white Clay	50	60
white Sand	60	165
white Clay	165	180
white Sand	180	200

WELL LOCATION:

sec. 4 T. 3 N. R. 3 E.
 4 miles S of Red Bank
 (distance) (direction) (nearest town)

WELL PURPOSE:

(home, irrigation, municipal, industrial)

WELL COMPLETION DATA:

- (1) diameter (inches) 4"
- (2) total depth (feet) 200
- (3) static water level (feet) 140 below top of ground
- (4) casing PVC 190 (material) (depth)
- (size) if telescope see back.
- (5) screen 4" 190 (length) (depth to top)
- (size) PVC (material)
- (6) pump 3/4 (HP) (yield gpm)
- Elec. (type power)
- (7) electric log NO (yes or no)

(organization running log)

- (8) how well bottom plugged CAP.


DRILLERS REMARKS:

CODED

APR 10 1973

If well telescopes please sketch and show depths.

GROUND LEVEL

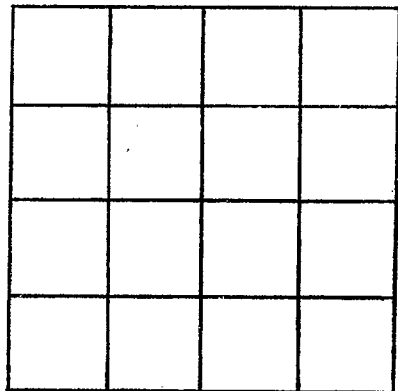

SECTION _____

Please indicate well location X.

ADDITIONAL INFORMATION

If more than one screen, show locations of each on sketch.