

MARSHALL
K 42
3-14-73

MISSISSIPPI
 BOARD OF WATER COMMISSIONERS
 416 North State Street
 Jackson, Mississippi 39201
WATER WELL DRILLERS LOG

CODED

3-14- 1973 Robert W. Gibson Marshall
 date well completed firm name county well located

LANDOWNER Lucie Mae Ingram
Holly Springs, Miss.
 (mailing address)

description of formations encountered	from	to
red clay, red sand		
white clay, red sand	0	30
red sand	30	135
red sand, white clay	135	150
white clay, white sand	150	165
white sand	165	210

WELL LOCATION:
 sec. 4 T 3 N. R. 3 E
 (S) (W)
 _____ miles _____ of _____
 (distance) (direction) (nearest town)

WELL PURPOSE:
 (home, irrigation, municipal, industrial)

WELL COMPLETION DATA:

(1) diameter (inches) 4

(2) total depth (feet) 210

(3) static water level (feet) 50 below above top of ground.

(4) casing _____, _____, _____
 (material) (depth)
 _____ if telescope see back.
 (size)

(5) screen 8, _____, _____
 (length) (depth to top)
4, _____, _____
 (size) (material)

(6) pump 3/4, _____
 (HP) (yield gpm)
electric
 (type power)

(7) electric log _____
 (yes or no)

 (organization running log)


(8) how well bottom plugged plastic cap

CODED

DRILLERS REMARKS: _____
 APR 9 1973

If well telescopes please sketch and show depths.

GROUND LEVEL

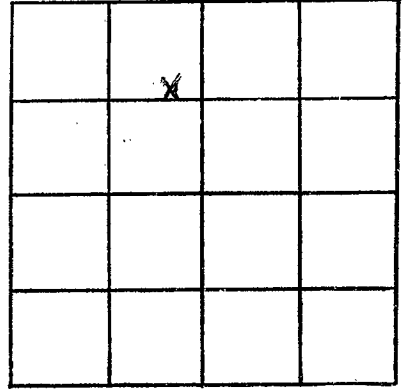

SECTION 24

Please indicate well location X.

ADDITIONAL INFORMATION

If more than one screen,
show locations of each on sketch.