

MARSHALL
K43
5-31-73

MISSISSIPPI
BOARD OF WATER COMMISSIONERS
416 North State Street
Jackson, Mississippi 39201

CODED

WATER WELL DRILLERS LOG

5-31 1973 date well completed Peterson & Fort Marshall firm name county well located

LANDOWNER:

William Peir
Hally Spring Missn
(mailing address)

description of formations encountered

from to

Clay	0	6
reddish	6	10
sand	10	160
Clay	160	190
white sand	190	245

WELL LOCATION:

sec. 1 T. 3 N. R. 3 E.
5 miles NE of Hally Spring
(distance) (direction) (nearest town)

WELL PURPOSE: home
(home, irrigation, municipal, industrial)

WELL COMPLETION DATA:

- (1) diameter (inches) 4"
- (2) total depth (feet) 245
- (3) static water level (feet) 186 below above top of ground.
- (4) casing P.V.C. 235 (material) (depth)
(size) if telescope see back.
- (5) screen 10 235 (length) (depth to top)
4" P.V.C. (size) (material)
- (6) pump 3/4 10 (HP) (yield gpm)
Elec. (type power)
- (7) electric log No (yes or no)
(organization running log)
- (8) how well bottom plugged CAP.


CODED

JUN 6 1973

DRILLERS REMARKS:

If well telescopes please
sketch and show depths.

GROUND LEVEL

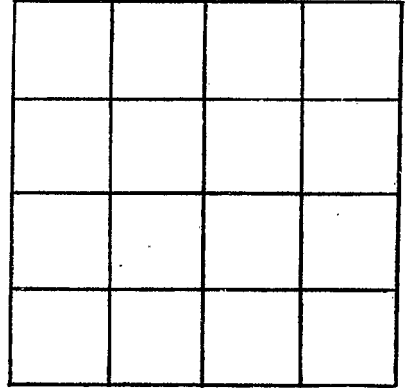

SECTION _____

Please indicate well location X.

ADDITIONAL INFORMATION

If more than one screen,
show locations of each on sketch.