

MARSHALL
K 44
5-31-73

MISSISSIPPI
 BOARD OF WATER COMMISSIONERS
 416 North State Street
 Jackson, Mississippi 39201

CODE

WATER WELL DRILLERS LOG

May 31 1973 Earl Jones Well Co- Marshall
 date well completed firm name county well located

LANDOWNER:
Terrill Clayton
Holly Springs RT.
 (mailing address)

description of formations encountered	from	to
<u>Topsoil - clay</u>	<u>0</u>	<u>16</u>
<u>sand</u>	<u>16</u>	<u>40</u>
<u>clay</u>	<u>40</u>	<u>42</u>
<u>sand</u>	<u>42</u>	<u>85</u>
<u>clay</u>	<u>85</u>	<u>95</u>
<u>sand</u>	<u>95</u>	<u>176</u>

WELL LOCATION:
 sec 33 T. 3 N R. 3 E
4 miles W of Holly Springs
 (distance) (direction) (nearest town)

WELL PURPOSE: Home
 (home, irrigation, municipal, industrial)

- WELL COMPLETION DATA:
- (1) diameter (inches) 4
 - (2) total depth (feet) 176
 - (3) static water level (feet) 90 below top of ground.
 - (4) casing plastic (material), 170 (depth)
4" (size) if telescope see back.
 - (5) screen 6" (length), 170 (depth to top)
4" (size), plastic gravel (material)
 - (6) pump 1/2 (HP), 18 (yield gpm)
Electric (type power)
 - (7) electric log No (yes or no)
- (organization running log)

CODE


(8) how well bottom plugged
plastic cup

DRILLERS REMARKS:

1 1 1073

If well telescopes please sketch and show depths.

GROUND LEVEL

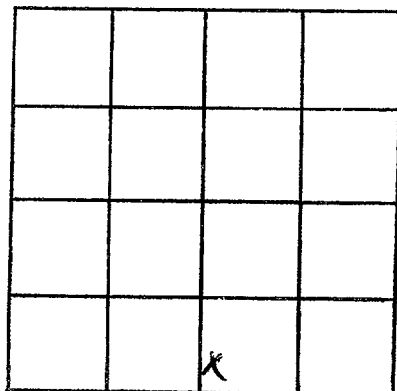

SECTION 33

Please indicate well location X.

ADDITIONAL INFORMATION

If more than one screen,
show locations of each on sketch.