

MARSHALL  
K 45  
1-20-73

MISSISSIPPI  
BOARD OF WATER COMMISSIONERS  
416 North State Street  
Jackson, Mississippi

CODED

WATER WELL DRILLERS LOG

1-20 1973 Leah Well Co Marshall  
date well completed firm name county well located

LANDOWNER:

Charles McClain

description of formations encountered

from to

Red Banks, miss  
(mailing address)

Surface clay - 0 16  
red clay + fine sand 16 48  
fine white sand + clay 48 160  
Coarse sand 160 170

WELL LOCATION:

sec 32 T 3 N R 3 E  
2 miles S of Red Banks  
(distance) (direction) (nearest town)

WELL PURPOSE: home  
(home, irrigation, municipal, industrial)

WELL COMPLETION DATA:

- (1) diameter (inches) 4"
- (2) total depth (feet) 170
- (3) static water level (feet) 137 below top of ground.
- (4) casing PVC, 164,  
(material), (depth)  
6" if telescope see back.  
(size)
- (5) screen 6', 164  
(length), (depth to top)  
4", PVC gravel pack  
(size), (material)
- (6) pump 1/2, 15  
(HP), (yield gpm)  
1/2 hp  
(type power)
- (7) electric log \_\_\_\_\_  
(yes or no)  
\_\_\_\_\_  
(organization running log)
- (8) how well bottom plugged PVC plug


CODED

JUL 2 1973

DRILLERS REMARKS:

If well telescopes please sketch and show depths.

GROUND LEVEL

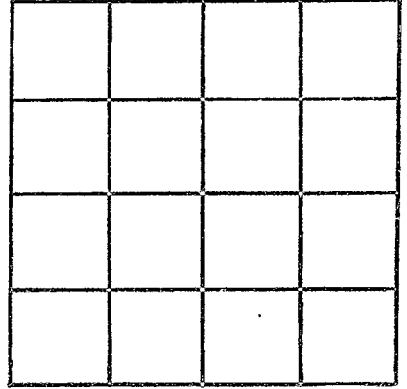

SECTION \_\_\_\_\_

Please indicate well location X.

ADDITIONAL INFORMATION

If more than one screen,  
show locations of each on sketch.