

CODED

MARSHALL
R 46
8/73

MISSISSIPPI
BOARD OF WATER COMMISSIONERS
416 North State Street
Jackson, Mississippi 39201

WATER WELL DRILLERS LOG

Atkinson & Faust Marshall

19 date well completed firm name county well located

LANDOWNER:

William Pain
Holly Springs Miss
(mailing address)

description of formations encountered

from to

Red Clay 0 15
Mix Clays and Sand 15 35
Red Sand 35 60
White sand 60 190
White Clay 190 200
White Sand 200 240

WELL LOCATION:

sec. 1 T 3 N R 3 E
4 miles west of Holly Springs
(distance) (direction) (nearest town)

WELL PURPOSE:

(home, irrigation, municipal, industrial)

WELL COMPLETION DATA:

- (1) diameter (inches) 4 1/2
- (2) total depth (feet) 240
- (3) static water level (feet) 200 below top of ground
- (4) casing PVC (material) (depth)
- (size) If telescope see back.
- (5) screen 10 FT 230 (length) (depth to top)
- 4" PVC (size) (material)
- (6) pump 3 (HP) 10 (yield gpm)
- Elec (type power)
- (7) electric log no. (yes or no)

(organization running log)

(8) how well bottom plugged CAP


CODED

AUG 10 1973

DRILLERS REMARKS:

If well telescopes please sketch and show depths.

GROUND LEVEL

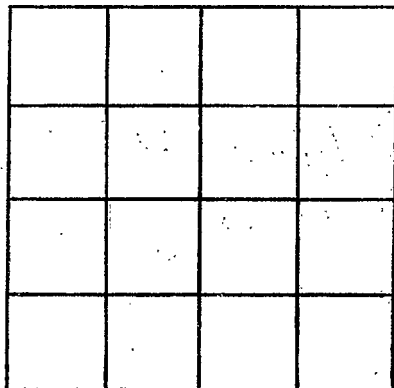

SECTION _____

Please indicate well location X.

ADDITIONAL INFORMATION

If more than one screen,
show locations of each on sketch.