

K 48  
 MARSHALL  
 3-27-73

MISSISSIPPI  
 BOARD OF WATER COMMISSIONERS  
 416 North State Street  
 Jackson, Mississippi 39201

CODED

WATER WELL DRILLERS LOG

March 27, 1973 R. L. Caperton Marshall  
 date well completed firm name county well located

LANDOWNER: Kenneth Smith  
 Holly Springs  
 Miss.  
 (mailing address)

WELL LOCATION:  
 sec 36 T 3 N R 3 E  
 2 miles East of Holly Springs  
 (distance) (direction) (nearest town)

WELL PURPOSE: Home  
 (home, irrigation, municipal, industrial)

- WELL COMPLETION DATA:
- (1) diameter (inches) 4
  - (2) total depth (feet) 265
  - (3) static water level (feet) 212 below top of ground.
  - (4) casing Plastic, 252 ft.  
 (material) (depth)  
 (size) If telescope see back.
  - (5) screen 13 ft., 252 ft.  
 (length) (depth to top)  
4 in., Plastic & Hard  
 (size) (material)
  - (6) pump 1, 12  
 (HP) (yield gpm)  
Elec.  
 (type power)
  - (7) electric log No  
 (yes or no)  
 (organization running log)
  - (8) how well bottom plugged Plastic cap


description of formations encountered	from	to
Surface Soil	0	25
med. Red Sand	25	46
med. White Sand	46	150
white clay	150	168
med. white sand	168	230
white coarse sand	230	265

DRILLERS REMARKS:

AUG 17 1973

If well telescopes please sketch and show depths.

GROUND LEVEL

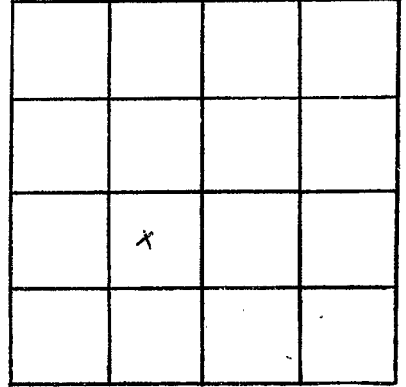

SECTION 36

Please indicate well location X.

ADDITIONAL INFORMATION

If more than one screen,  
show locations of each on sketch.