

123

K 49
MARSHALL
4-11-73

MISSISSIPPI
 BOARD OF WATER COMMISSIONERS
 416 North State Street
 Jackson, Mississippi 39201

CODED

WATER WELL DRILLERS LOG

4-11-1973 date well completed Robert W. Wilson firm name Marshall county well located

LANDOWNER: James E Howell
Holly Spivey, Miss
 (mailing address)

description of formations encountered	from	to
red clay, red sand	0	30
red sand	30	105
red sand, white clay, white sand	105	120
white sand	120	150
white clay, white sand	150	165
white sand	165	180

WELL LOCATION:
 sec. 24 T. 3 N. R. 3 E.
 (distance) miles of (direction) of (nearest town)

WELL PURPOSE:
 (home, irrigation, municipal, industrial)

WELL COMPLETION DATA:

(1) diameter (inches) 4

(2) total depth (feet) 180

(3) static water level (feet) 80 below above top of ground.

(4) casing Plastic 180
 (material) (depth)

_____ if telescope see back.
 (size)

(5) screen 8 172
 (length) (depth to top)

4 gravel packed
 (size) (material)

(6) pump 3/4 10
 (HP) (yield gpm)

electric
 (type power)

(7) electric log _____
 (yes or no)

_____ (organization running log)

(8) how well bottom plugged 42"
plastic cap


CODED

DRILLERS REMARKS:

AUG 28 1973

If well telescopes please
sketch and show depths.

GROUND LEVEL

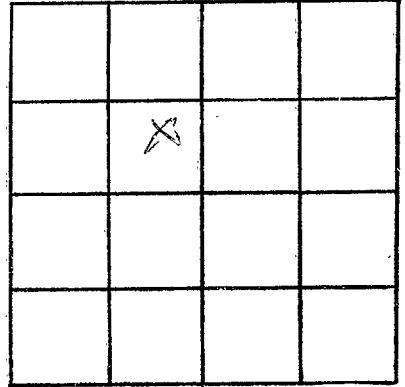

SECTION 20

Please indicate well location X.

ADDITIONAL INFORMATION

If more than one screen,
show locations of each on sketch.