

MARSHALL  
K 54  
10-25-73

MISSISSIPPI  
BOARD OF WATER COMMISSIONERS  
416 North State Street  
Jackson, Mississippi 39201

WATER WELL DRILLERS LOG CODED

01 25 19 73 Earl Jones Well Co Marshall  
date well completed firm name county well located

LANDOWNER:  
Richard Novarese  
Red Banks Miss.  
(mailing address)

description of formations encountered	from	to
Topsoil	0	5
Sand	5	50
clay	50	54
Sand	54	132
clay	132	160
sand	160	176

WELL LOCATION:  
sec. 17 T-3 N R-3 E  
1/4 miles SNE of Red Banks  
(distance) (direction) (nearest town)

WELL PURPOSE: Home  
(home, irrigation, municipal, industrial)

WELL COMPLETION DATA:

(1) diameter (inches) 4"  
(2) total depth (feet) 176'  
(3) static water level (feet) 117' below top of ground.  
(4) casing plastic (material), 170' (depth)  
4" (size) if telescope see back.  
(5) screen 6' (length), 170' (depth to top)  
4" (size), plastic gravel (material)  
(6) pump 1/2 (HP), 14 (yield gpm)  
Electric (type power)  
(7) electric log no (yes or no)  
(organization running log)

CODED


(8) how well bottom plugged  
plastic cap

DRILLERS REMARKS:

NOV 1973

If well telescopes please sketch and show depths.

GROUND LEVEL

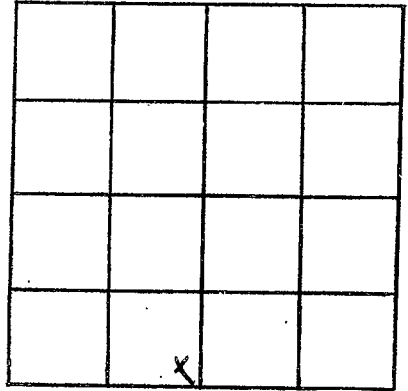

SECTION 17

Please indicate well location X.

ADDITIONAL INFORMATION

If more than one screen,  
show locations of each on sketch.