

MARSHALL
K55
10-20-73

MISSISSIPPI
 BOARD OF WATER COMMISSIONERS
 416 North State Street
 Jackson, Mississippi 39201

WATER WELL DRILLERS LOG

CODED

Oct. 20 1973 Earl Jones well co Marshall
 date well completed firm name county well located

LANDOWNER:
William Timmons
Bayholie Miss. RT.
 (mailing address)

WELL LOCATION:
~~Sec 27~~ T 3 N R 3 E
26 S W
4 1/2 miles SW of Red Bank
 (distance) (direction) (nearest town)

WELL PURPOSE: Home
 (home, irrigation, municipal, industrial)

WELL COMPLETION DATA:
 (1) diameter (inches) 4"
 (2) total depth (feet) 130
 (3) static water level (feet) 90 below above top of ground.
 (4) casing plastic 124
 (material) (depth)
4" if telescope see back.
 (size)
 (5) screen 6' 124
 (length) (depth to top)
4" plastic gravel
 (size) (material)
 (6) pump 1/2 15
 (HP) (yield gpm)
Electric
 (type power)
 (7) electric log no
 (yes or no)
 (organization running log)

description of fomations encountered	from	to
<u>Topsoil & clay</u>	<u>0</u>	<u>16</u>
<u>sand</u>	<u>16</u>	<u>30</u>
<u>clay</u>	<u>30</u>	<u>33</u>
<u>sand</u>	<u>33</u>	<u>70</u>
<u>clay</u>	<u>70</u>	<u>74</u>
<u>sand</u>	<u>74</u>	<u>130</u>


CODED

NOV 7 1973

DRILLERS REMARKS:

If well telescopes please sketch and show depths.

GROUND LEVEL

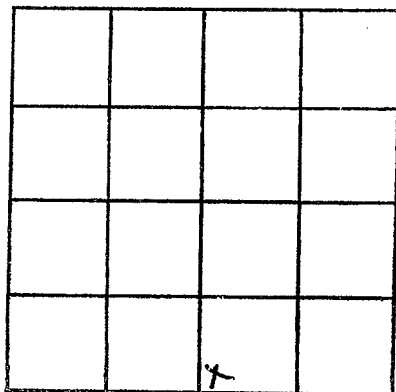

SECTION 26

Please indicate well location X.

ADDITIONAL INFORMATION

If more than one screen,
show locations of each on sketch.