

**MARSHALL**  
**K 56**  
**12-11-73**

MISSISSIPPI  
 BOARD OF WATER COMMISSIONERS  
 416 North State Street  
 Jackson, Mississippi 39201

CODED

WATER WELL DRILLERS LOG

Dec 11 1973  
 date well completed

Earl Jones well co  
 firm name

Marshall  
 county well located

LANDOWNER:

Hazel Payne

Holly Springs, Miss, RT.  
 (mailing address)

WELL LOCATION:

sec 5 T 3 N R 3 E  
 S W  
3 miles NE of Red Bank  
 (distance) (direction) (nearest town)

WELL PURPOSE: Home  
 (home, irrigation, municipal, industrial)

WELL COMPLETION DATA:

- (1) diameter (inches) 4"
- (2) total depth (feet) 142
- (3) static water level (feet) 98 ~~above~~ below top of ground.
- (4) casing plastic, 136,  
 (material) (depth)  
4" if telescope see back.  
 (size)
- (5) screen 6', 136  
 (length) (depth to top)  
4", plastic gravel  
 (size) (material)
- (6) pump 1/2 76  
 (HP) (yield gpm)  
Electric  
 (type power)
- (7) electric log no  
 (yes or no)

(organization running log)

(8) how well bottom plugged  
plastic bags

DRILLERS REMARKS:

description of formations encountered

from

to

Topsoil & clay  
 sand  
 clay  
 sand

0 15  
 15 47  
 47 58  
 58 142


CODED

DEC 20 1973

MISSISSIPPI  
 WATER COMMISSION

If well telescopes please sketch and show depths.

GROUND LEVEL

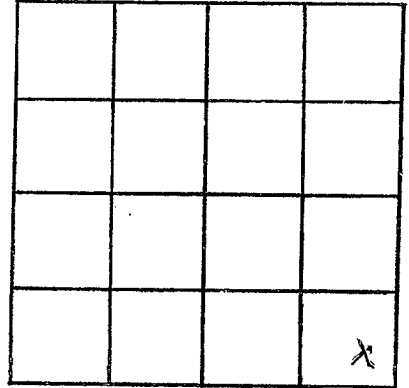

SECTION 5

Please indicate well location X.

ADDITIONAL INFORMATION

If more than one screen,  
show locations of each on sketch.