

MISSISSIPPI  
 BOARD OF WATER COMMISSIONERS  
 416 North State Street  
 Jackson, Mississippi 39201

**MARSHALL**


**K57**

**4-24-74**

**WATER WELL DRILLERS LOG**

4-24-74 1974 Deint Benjamin Marshall  
 date well completed firm name county well located

LANDOWNER:	description of formations encountered	from	to
<u>Thurman Halmer</u>		<u>clay</u>	<u>0</u>
<u>Holly Springs, Miss</u> (mailing address)	<u>sand</u>	<u>35</u>	<u>110</u>
WELL LOCATION:	<u>clay</u>	<u>110</u>	<u>120</u>
sec <u>35</u> T <u>3</u> N <u>3</u> E (S) (W)	<u>sand</u>	<u>120</u>	<u>200</u>
<u>5</u> miles <u>West</u> of <u>H.S.</u> (distance) (direction) (nearest town)			
WELL PURPOSE: <u>Chloride</u> (home, irrigation, municipal, industrial)			
WELL COMPLETION DATA:			
(1) diameter (inches) <u>4"</u>			
(2) total depth (feet) <u>200 feet</u>			
(3) static water level (feet) <u>125</u> below top of ground.			
(4) casing <u>PVC</u> , <u>200 feet</u> (material) (depth)			
<u>        </u> if telescope see back. (size)			
(5) screen <u>7ft</u> , <u>193 feet</u> (length) (depth to top)			
<u>4"</u> , <u>gravel wall</u> (size) (material)			
(6) pump <u>3/4</u> <u>14</u> (HP) (yield/gpm)			
<u>        </u> (type power)			
(7) electric log <u>Elect.</u> (yes or no)			
<u>        </u> (organization running log)			
(8) how well bottom plugged <u>4" of</u>			
DRILLERS REMARKS:			

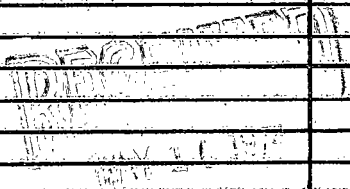

well telescopes please  
sketch and show depths.

GROUND LEVEL


SECTION \_\_\_\_\_

Please indicate well location X.

ADDITIONAL INFORMATION

If more than one screen,  
show locations of each on sketch.