

MARSHALL
K59
5/74

MISSISSIPPI
BOARD OF WATER COMMISSIONERS
416 North State Street
Jackson, Mississippi 39201

CODED

WATER WELL DRILLERS LOG

date well completed 19 Attorney At Law firm name Marshall county well located

OWNER: ANDREW BERT
Flying Bishop
Holly Springs miss
(mailing address)

description of formations encountered	depth	
	from	to
Clay	0	30
sand	30	140
white clay	140	185

WELL LOCATION:
sec. 1 T. 3 N. R. 3 E.
3 miles NW of Holly Springs
(distance) (direction) (nearest town)

WELL PURPOSE: Industrial
(home, irrigation, municipal, industrial)

CODED

- WELL COMPLETION DATA:
- (1) diameter (inches) 4 1/2
 - (2) total depth (feet) 185
 - (3) static water level (feet) 130 below top of ground.
 - (4) casing PVC 175
(material) (depth)
 - (size) If telescope see back.
 - (5) screen 175 185
(length) (depth to top)
 - (size) (material)
 - (6) pump 1 12
(HP) (yield gpm)
 - elec
(type power)
 - (7) electric log NO
(yes or no)
 - (organization running log)
 - (8) how well bottom plugged CAP


DRILLERS REMARKS:

MAY 16 1974

MISS. Bd. OF WATER COMMISSIONERS

If well telescopes please sketch and show depths.

GROUND LEVEL

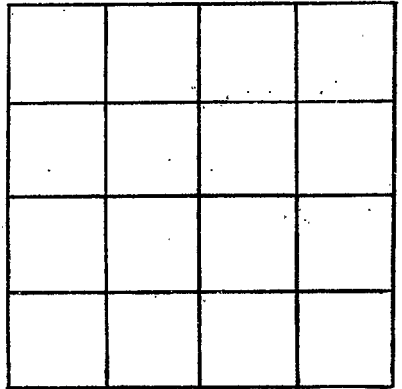

SECTION _____

Please indicate well location X.

ADDITIONAL INFORMATION

If more than one screen, show locations of each on sketch.