

MARSHALL
K61
5-24-74

MISSISSIPPI
 BOARD OF WATER COMMISSIONERS CODED
 416 North State Street
 Jackson, Mississippi 39201

WATER WELL DRILLERS LOG

5-24 1974 *Thick Bros. Well Co.* *Marshall*
 date well completed firm name county well located

LANDOWNER: *Burnetts*
Kilgore - P.O. Box
384, Holly Springs
 (mailing address) *Miss.*

WELL LOCATION:
 sec *33* T *3* N R *3* E
4 miles *N* of *Holly Springs*
 (distance) (direction) (nearest town)

description of formations encountered	from	to
<i>Red Clay</i>	<i>0</i>	<i>15</i>
<i>White Clay</i>	<i>15</i>	<i>30</i>
<i>White sand & clay</i>	<i>30</i>	<i>60</i>
<i>White sand</i>	<i>60</i>	<i>105</i>
<i>white sand & clay</i>	<i>105</i>	<i>205</i>
<i>white sand</i>	<i>205</i>	<i>250</i>

WELL PURPOSE:
 (home, irrigation, municipal, industrial)

WELL COMPLETION DATA:

(1) diameter (inches) *4 1/2*
 (2) total depth (feet) *250*
 (3) static water level (feet) *150* below above top of ground.
 (4) casing *Plastic*, *250*
 (material) (depth)
 (size) if telescope see back.
 (5) screen *4 ft*, *246*
 (length) (depth to top)
4 1/2, *Gravel*
 (size) (material)
 (6) pump *1/2* *8*
 (HP) (yield gpm)
220
 (type power)
 (7) electric log *no*
 (yes or no)
 (organization running log)
 (8) how well bottom plugged *0.4*

CODED


PROPERTY OF
 MISS. - I 1974

DRILLERS REMARKS:

MISS. BD. OF WATER COMM

If well telescopes please sketch and show depths.

GROUND LEVEL

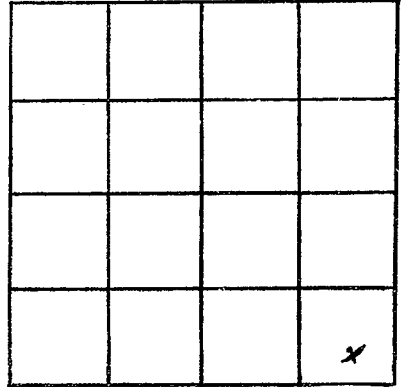

SECTION 33

Please indicate well location X.

ADDITIONAL INFORMATION

If more than one screen,
show locations of each on sketch.