

MARSHALL
K62
8-7-74

MISSISSIPPI
 BOARD OF WATER COMMISSIONERS
 416 North State Street
 Jackson, Mississippi 39201

CODED

WATER WELL DRILLERS LOG

8-7 19 74 Bob Smith & Son Marshall
 date well completed firm name county well located

LANDOWNER:
William Shackelford
Redbank, Miss.
 (mailing address)

description of formations encountered	from	to
<u>Top soil</u>	<u>0'</u>	<u>15'</u>
<u>yellow & red sand</u>	<u>15'</u>	<u>25'</u>
<u>white sand</u>	<u>25'</u>	<u>40'</u>
<u>white sand</u>	<u>40'</u>	<u>230'</u>

WELL LOCATION:
 sec 30 T 3 N R 3 E
 (S) (W)
1 1/2 miles S of Red Bank
 (distance) (direction) (nearest town)

WELL PURPOSE:
 (home, irrigation, municipal, industrial)

WELL COMPLETION DATA:

- (1) diameter (inches) 4"
- (2) total depth (feet) 230'
- (3) static water level (feet) 140' below top of ground.
- (4) casing Plastic, 230'
 (material) (depth)
 (size) If telescope see back.
- (5) screen 10', 220'
 (length) (depth to top)
4", Plastic
 (size) (material)
- (6) pump 1/2 10
 (HP) (yield gpm)
electric
 (type power)
- (7) electric log no
 (yes or no)

CODED

(organization running log)

(8) how well bottom plugged plugged

RECEIVED
MISSISSIPPI


AUG 16 1974

DRILLERS REMARKS:

MISS. BD. OF WATER COMM

If well telescopes please sketch and show depths.

GROUND LEVEL

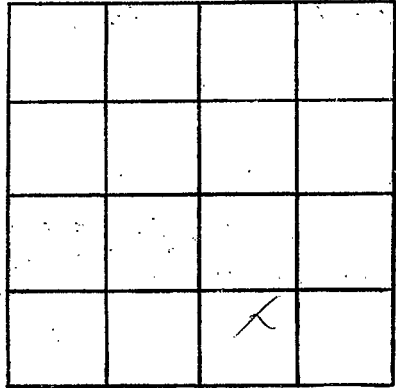

SECTION 30

Please indicate well location X.

ADDITIONAL INFORMATION

If more than one screen, show locations of each on sketch.