

**MARSHALL**  
**K63**  
**8-6-74**

MISSISSIPPI  
 BOARD OF WATER COMMISSIONERS  
 416 North State Street  
 Jackson, Mississippi 39201

CODED

WATER WELL DRILLERS LOG

Aug 6 1974 Earl Jones Well Co Marshall  
 date well completed firm name county well located

LANDOWNER:

Carie L. Thomas

Holly Springs Miss. Pct.  
 (mailing address)

WELL LOCATION:

sec. 13 T-3 N R-3 E  
3 3/4 miles NW. of Holly Springs  
 (distance) (direction) (nearest town)

WELL PURPOSE: Home  
 (home, irrigation, municipal, industrial)

WELL COMPLETION DATA:

- (1) diameter (inches) 4"  
 (2) total depth (feet) 125  
 (3) static water level (feet) 90 below above top of ground.  
 (4) casing plastic, 119  
 (material) (depth)  
4" if telescope see back.  
 (size)  
 (5) screen 6', 119  
 (length) (depth to top)  
4", plastic gravel  
 (size) (material)  
 (6) pump 1/2, 16  
 (HP) (yield gpm)  
electric  
 (type power)  
 (7) electric log no  
 (yes or no)

(organization running log)

(8) how well bottom plugged  
plastic cap

description of formations encountered

from to

<u>Topsoil</u>	<u>0</u>	<u>10</u>
<u>sand</u>	<u>10</u>	<u>17</u>
<u>clay</u>	<u>17</u>	<u>25</u>
<u>sand</u>	<u>25</u>	<u>60</u>
<u>clay</u>	<u>60</u>	<u>72</u>
<u>sand</u>	<u>72</u>	<u>125</u>

RECORDED  
 INDEXED


AUG 21 1974

DRILLERS REMARKS:

MISS. BD. OF WATER COMM

If well telescopes please sketch and show depths.

GROUND LEVEL

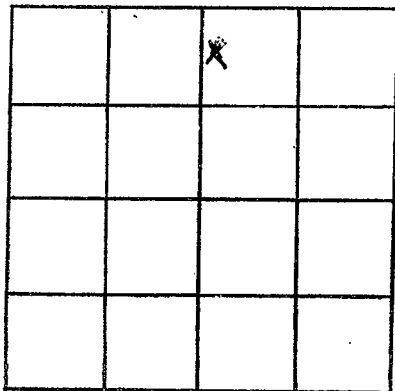

SECTION B

Please indicate well location X.

ADDITIONAL INFORMATION

If more than one screen,  
show locations of each on sketch.