

MARSHALL
K64
9-17-74

MISSISSIPPI
 BOARD OF WATER COMMISSIONERS
 416 North State Street
 Jackson, Mississippi 39201

CODED

WATER WELL DRILLERS LOG

date well completed 9-17-74 firm name Hickson Drilling Co. county well located Marshall

LANDOWNER: Wildwood
Sub - Collins Ave.
Holly Springs, Miss.
 (mailing address)

description of formations encountered	from	to
<u>Red Sand</u>	<u>0</u>	<u>15</u>
<u>White Sand</u>	<u>15</u>	<u>45</u>
<u>White Clay</u>	<u>45</u>	<u>100</u>
<u>White Sand</u>	<u>100</u>	<u>214</u>

WELL LOCATION:
 sec 32 T 3 N R 3 E
4 miles W of Marshall
 (distance) (direction) (nearest town)

WELL PURPOSE: Home
 (home, irrigation, municipal, industrial)

WELL COMPLETION DATA:

- (1) diameter (inches) 4 in
- (2) total depth (feet) 214
- (3) static water level (feet) 150 below top of ground.
- (4) casing Electric, 214
 (material) (depth)
 _____ If telescope see back.
 (size)
- (5) screen 3, 206
 (length) (depth to top)
4 in., Steel
 (size) (material)
- (6) pump 1 1/2, 10
 (HP) (yield gpm)
Electric, 250
 (type power)
- (7) electric log NO
 (yes or no)

 (organization running log)
- (8) how well bottom plugged Cap


DRILLERS REMARKS: _____

RECEIVED

SEP 25 1974

If well telescopes please
sketch and show depths.

GROUND LEVEL

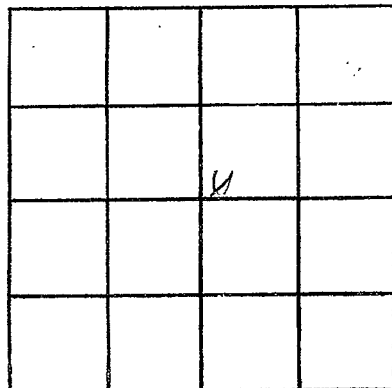

SECTION 32

Please indicate well location X.

ADDITIONAL INFORMATION

If more than one screen,
show locations of each on sketch.