

MARSHALL
K 65
8/29/74

MISSISSIPPI
 BOARD OF WATER COMMISSIONERS
 416 North State Street
 Jackson, Mississippi 39201

INDEXED

WATER WELL DRILLERS LOG


aug 29 1974 R.L. Carpenter Marshall
 date well completed firm name county well located

LANDOWNER:	description of formations encountered	from	to
<u>Earlene Brown</u>	<u>surface soil</u>	<u>0</u>	<u>18</u>
<u>Holly Springs,</u>	<u>med. red sand</u>	<u>18</u>	<u>38</u>
<u>miss. RFD</u>	<u>white fine sand</u>	<u>38</u>	<u>60</u>
(mailing address)	<u>white clay</u>	<u>60</u>	<u>75</u>
WELL LOCATION:	<u>med. white sand</u>	<u>75</u>	<u>98</u>
sec. <u>13</u> T. <u>3</u> N. R. <u>3</u> E	<u>white clay</u>	<u>98</u>	<u>120</u>
<u>4</u> miles <u>North</u> of <u>Holly Springs</u>	<u>white fine sand</u>	<u>120</u>	<u>140</u>
(distance) (direction) (nearest town)	<u>white coarse sand</u>	<u>120</u>	<u>160</u>
WELL PURPOSE: <u>Home</u>			
(home, irrigation, municipal, industrial)			
WELL COMPLETION DATA:			
(1) diameter (inches) <u>4 in.</u>			
(2) total depth (feet) <u>160</u>			
(3) static water level (feet) <u>85</u> below above top of ground.			
(4) casing <u>Plastic</u> <u>154 ft.</u>			
(material) (depth)			
(size) if telescope see back.			
(5) screen <u>6 ft.</u> <u>154 ft.</u>			
(length) (depth to top)			
<u>4 in.</u> <u>Plastic</u>			
(size) (material)			
(6) pump <u>3/4</u> <u>10</u>			
(HP) (yield gpm)			
<u>Elec.</u>			
(type power)			
(7) electric log <u>No</u>			
(yes or no)			
(organization running log)			
(8) how well bottom plugged <u>Plastic cap</u>			
DRILLERS REMARKS:			

MISS. BOARD OF WATER COMMISSIONERS
 OCT - 4 1974
 MISS. R.D. OF WATER COMMISSIONERS

If well telescopes please sketch and show depths.

GROUND LEVEL

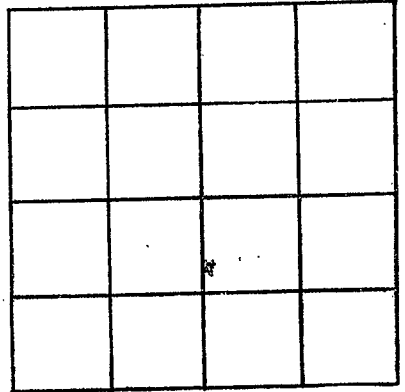

SECTION 13

Please indicate well location X.

ADDITIONAL INFORMATION

If more than one screen, show locations of each on sketch.