

MARSHALL

K 66

4-16-74

MISSISSIPPI
 BOARD OF WATER COMMISSIONERS
 416 North State Street
 Jackson, Mississippi 39201

INDEXED

WATER WELL DRILLERS LOG

April 16 1974
date well completed

R. L. Cozette
firm name

Marshall
county well located

LANDOWNER: Frank Murray
Holly Springs
Miss. RFD
 (mailing address)

description of formations encountered	from	to
Surface Soil	0	18
Coarse Red Sand	18	35
Red clay	35	38
Coarse white sand	38	60
Med. white sand	60	100
white clay	100	112
white coarse sand	112	168

WELL LOCATION:
 sec. 17 T 3 N R 3 E
4 miles West of Holly Springs
 (distance) (direction) (nearest town)


WELL PURPOSE: Home
 (home, irrigation, municipal, industrial)

- WELL COMPLETION DATA:
- (1) diameter (inches) 4
 - (2) total depth (feet) 168
 - (3) static water level (feet) 130 below top of ground.
 - (4) casing Plastic, 162 ft. (material) (depth)
 (size) if telescope see back.
 - (5) screen 6 ft., 162 ft. (length) (depth to top)
4 in., Plastic Sand (size) (material)
 - (6) pump 3/4, 18 (HP) (yield gpm)
Elec. (type power)
 - (7) electric log no. (yes or no)

(organization running log)
Plastic cap

(8) how well bottom plugged


DRILLERS REMARKS:

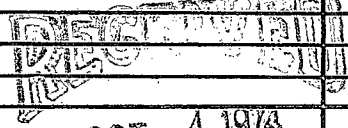

OCT - 4 1974

If well telescopes please sketch and show depths.

GROUND LEVEL

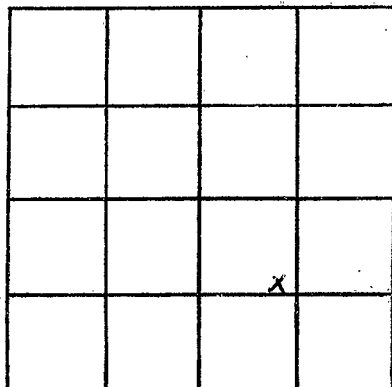

SECTION L7

Please indicate well location X.

ADDITIONAL INFORMATION

If more than one screen, show locations of each on sketch.