

MARSHALL
K67
9/12/74

MISSISSIPPI
BOARD OF WATER COMMISSIONERS
416 North State Street
Jackson, Mississippi 39201

CODED

WATER WELL DRILLERS LOG

9-12-1974 Deant Ketburgess Marshall
date well completed firm name county well located

LANDOWNER:
Bessie Jubble
144 Holly Springs, Miss
(mailing address)

description of formations encountered		from	to
clay		0	30
sand		30	65
clay		65	80
sand		80	175

WELL LOCATION:
sec. 27 T 3 N R 3 E
4 miles west of Holly Springs
(distance) (direction) (nearest town)

WELL PURPOSE: Drinking
(home, irrigation, municipal, industrial)

WELL COMPLETION DATA:

(1) diameter (inches) 4"

(2) total depth (feet) 175 feet

(3) static water level (feet) 100 ^{below} _{above} top of ground.

(4) casing PVC, 175 feet
(material) (depth)

 If telescope see back.
(size)

(5) screen 74", 168 feet
(length) (depth to top)

4", gravel well
(size) (material)

(6) pump 3/4, 14
(HP) (yield gpm)

(type power)

(7) electric log electric
(yes or no)

(organization running log)

(8) how well bottom plugged 40%

CODED


DRILLER'S SIGNATURE
OCT 10 1974

MISS. Bd. OF WATER COMMISSIONERS

DRILLERS REMARKS:

If well telescopes please
sketch and show depths.

GROUND LEVEL

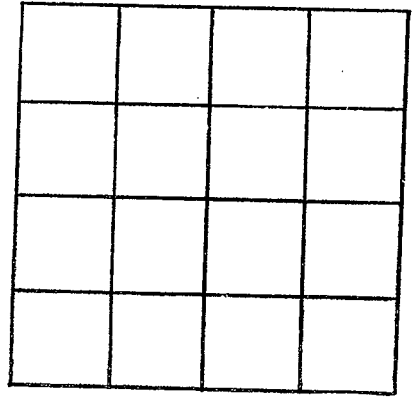

SECTION _____

Please indicate well location X.

ADDITIONAL INFORMATION

If more than one screen,
show locations of each on sketch.