

MARSHALL
K68
10/79

MISSISSIPPI
BOARD OF WATER COMMISSIONERS
416 North State Street
Jackson, Mississippi 39201

CODED

WATER WELL DRILLERS LOG

date well completed 19 October 1979 firm name Atkinson Fluid Marshall county well located Marshall


LANDOWNER: BESSIE O. Shaw
Holly Springs, Miss.
(mailing address) Nov 3, 11

description of formations encountered	from	to
<u>Brown Clay</u>	<u>0</u>	<u>15</u>
<u>Red Sand</u>	<u>15</u>	<u>35</u>
<u>White Clay</u>	<u>35</u>	<u>50</u>
<u>Brown Clay</u>	<u>50</u>	<u>85</u>
<u>White Sand</u>	<u>85</u>	<u>135</u>

WELL LOCATION:
sec. 1 T. 3 N. R. 3 E.
6 miles NE of Wellsburg
(distance) (direction) (nearest town)

WELL PURPOSE: home
(home, irrigation, municipal, industrial)

- WELL COMPLETION DATA:
- (1) diameter (inches) 4 1/2
 - (2) total depth (feet) 135
 - (3) static water level (feet) 90 below above top of ground.
 - (4) casing POC 125
(material) (depth)
 - (size) If telescope see back.
 - (5) screen 10 125
(length) (depth to top)
 - (size) (material)
 - (6) pump 1/2 10
(HP) (yield gpm)
 - Elec
(type power)
 - (7) electric log no
(yes or no)
 - (organization running log)
 - (8) how well bottom plugged Cap.

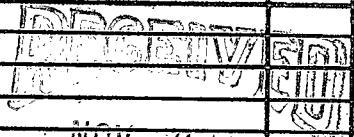


MISS. BD. OF WATER COMMISSIONERS

DRILLERS REMARKS:

If well telescopes please sketch and show depths.

GROUND LEVEL

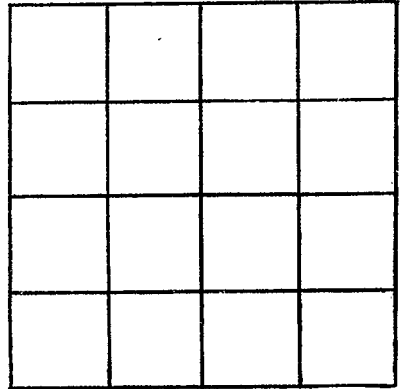

SECTION _____

Please indicate well location X.

ADDITIONAL INFORMATION

If more than one screen, show locations of each on sketch.