

MARSHALL

K69

4/75

MISSISSIPPI BOARD OF WATER COMMISSIONERS
416 North State Street
Jackson, Mississippi 39201

CODED

WATER WELL DRILLERS LOG

Retriever & Fuel Marshall

19 date well completed

firm name

county well located

LANDOWNER:

King
Nadamey
Nelly Springs

description of formations encountered

from

to

<i>Ground</i>	0	25
<i>Red sand</i>	25	65
<i>white clay</i>	65	80
<i>Black clay</i>	80	110
<i>White sand</i>	110	135

(mailing address)

WELL LOCATION:

sec. 1 T 3 N R 3 E
5 miles NW of Nelly Springs
(distance) (direction) (nearest town)

CODED

WELL PURPOSE:


(home, irrigation, municipal, industrial)

WELL COMPLETION DATA:

- (1) diameter (inches) 4 1/2
- (2) total depth (feet) 135
- (3) static water level (feet) 90 below above top of ground.
- (4) casing PVC, 125 (material) (depth)
- (size) if telescope see back.
- (5) screen 10, 125 (length) (depth to top)
- 4", PVC (size) (material)
- (6) pump 3, 10 (HP) (yield gpm)
- Elec (type power)
- (7) electric log no (yes or no)

(organization running log)

(8) how well bottom plugged cap.

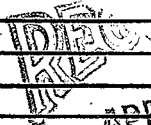


APR 29 1975

MISS. BO. OF WATER COMMISSIONERS

DRILLERS REMARKS:

If well telescopes please sketch and show depths.

GROUND LEVEL

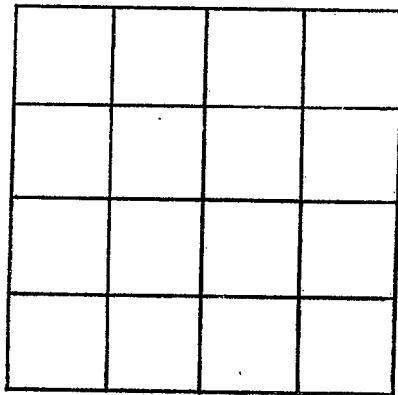

SECTION _____

Please indicate well location X.

ADDITIONAL INFORMATION

If more than one screen, show locations of each on sketch.